



NOTES

1. THIS DRAWING IS TO BE READ IN CONJUNCTION WITH ALL RELEVANT ARCHITECTS AND ENGINEERS DRAWINGS DETAILS AND SPECIFICATION.
2. THIS DRAWING IS NOT TO BE SCALED.

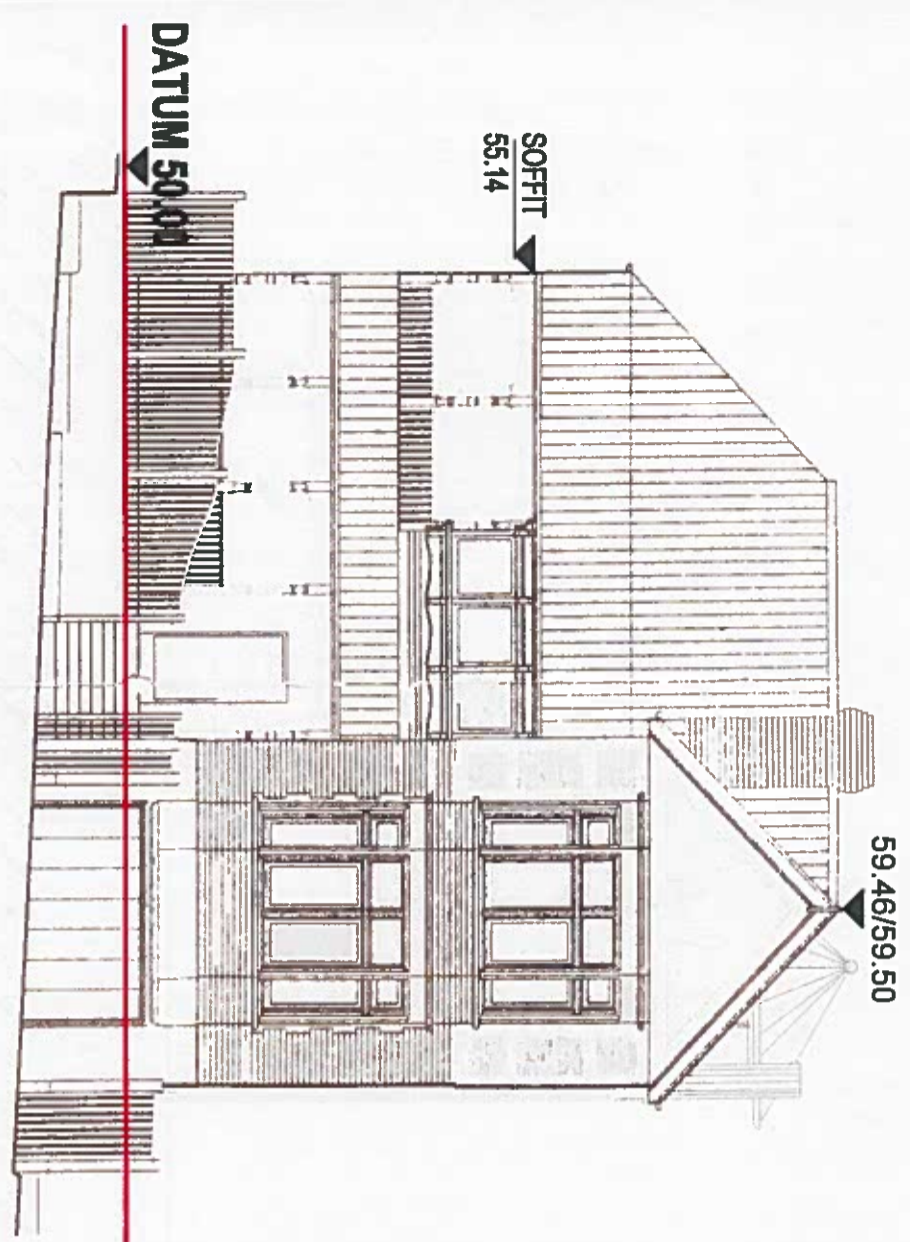

1 South Elevation - scale 1:100
P304 1996 permission

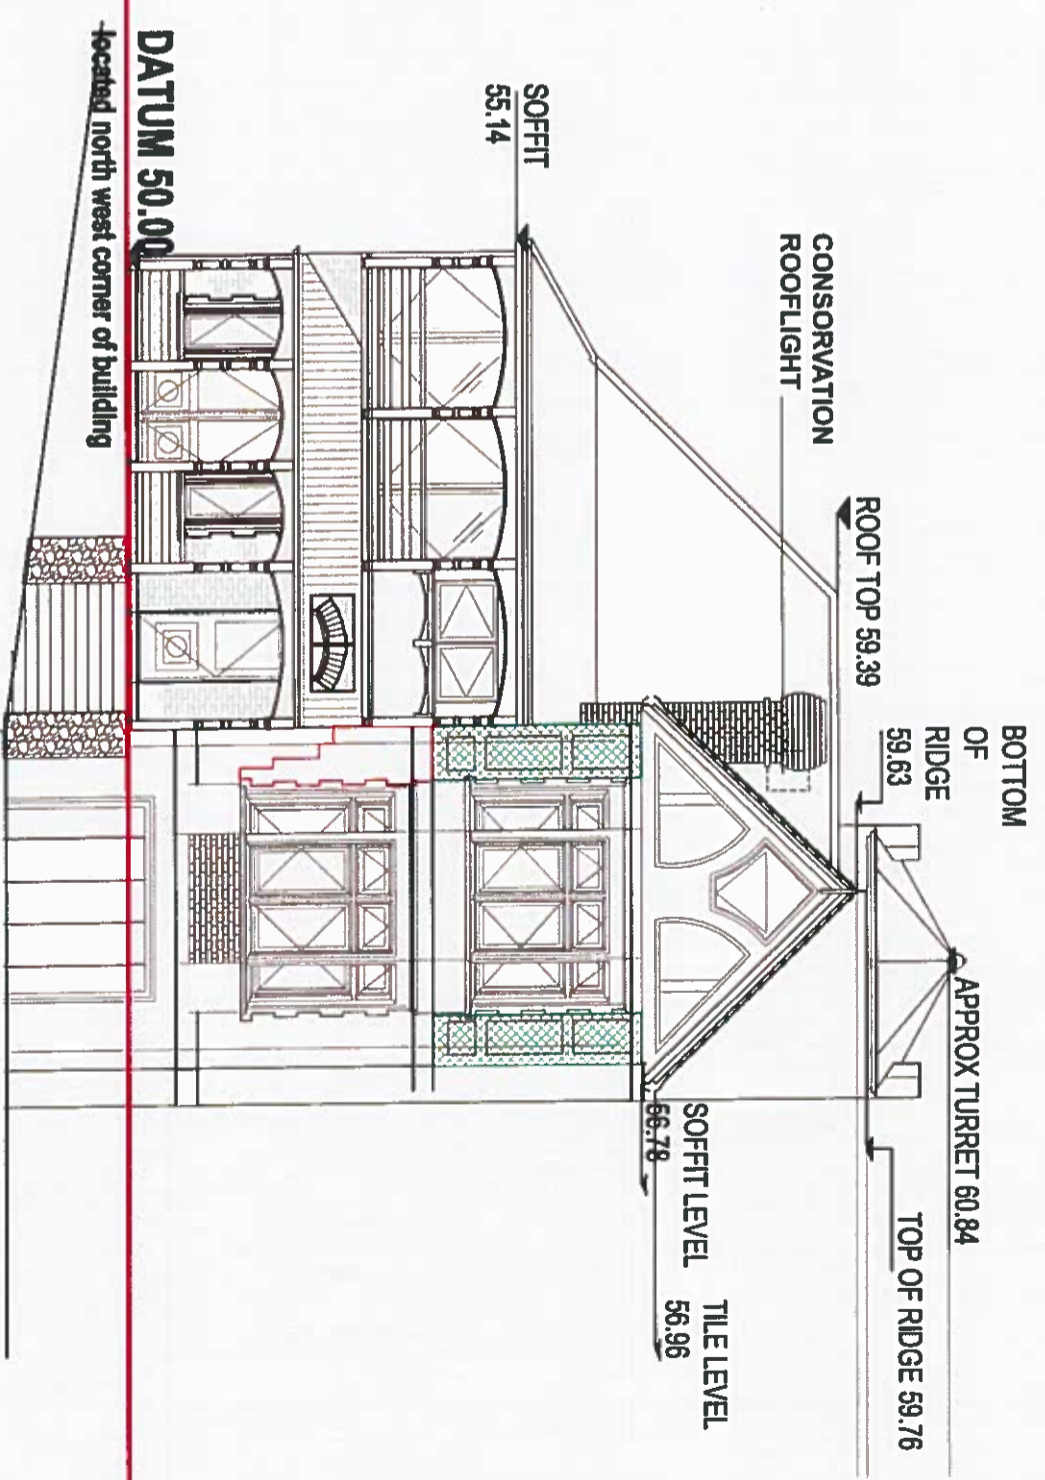

1 South Elevation - scale 1:100
P304 as built 2015/2016

DRAWING COMPARED BETWEEN 1996 PERMISSION AND AS BUILT

JOB NUMBER	90043	DATE	19-05-2016
SCALE:	1:100		
DRAWN:	IF	CHECKED:	GL
DRAWING NO	P301/P304	PLANN	PRELIM
		TENDER	CONSTR

GLS architects

1 DOCK ROAD
MELBOURNE VIC 3000
PHONE: 03 9419 1000
FAX: 03 9419 0999
Copyright Reserved
Architects, Planners, Surveyors & Engineers