


- NOTES
1. THIS DRAWING IS TO BE READ IN CONJUNCTION WITH ALL RELEVANT ARCHITECTS AND ENGINEERS DRAWINGS DETAILS AND SPECIFICATION.
 2. THIS DRAWING IS NOT TO BE SCALED.

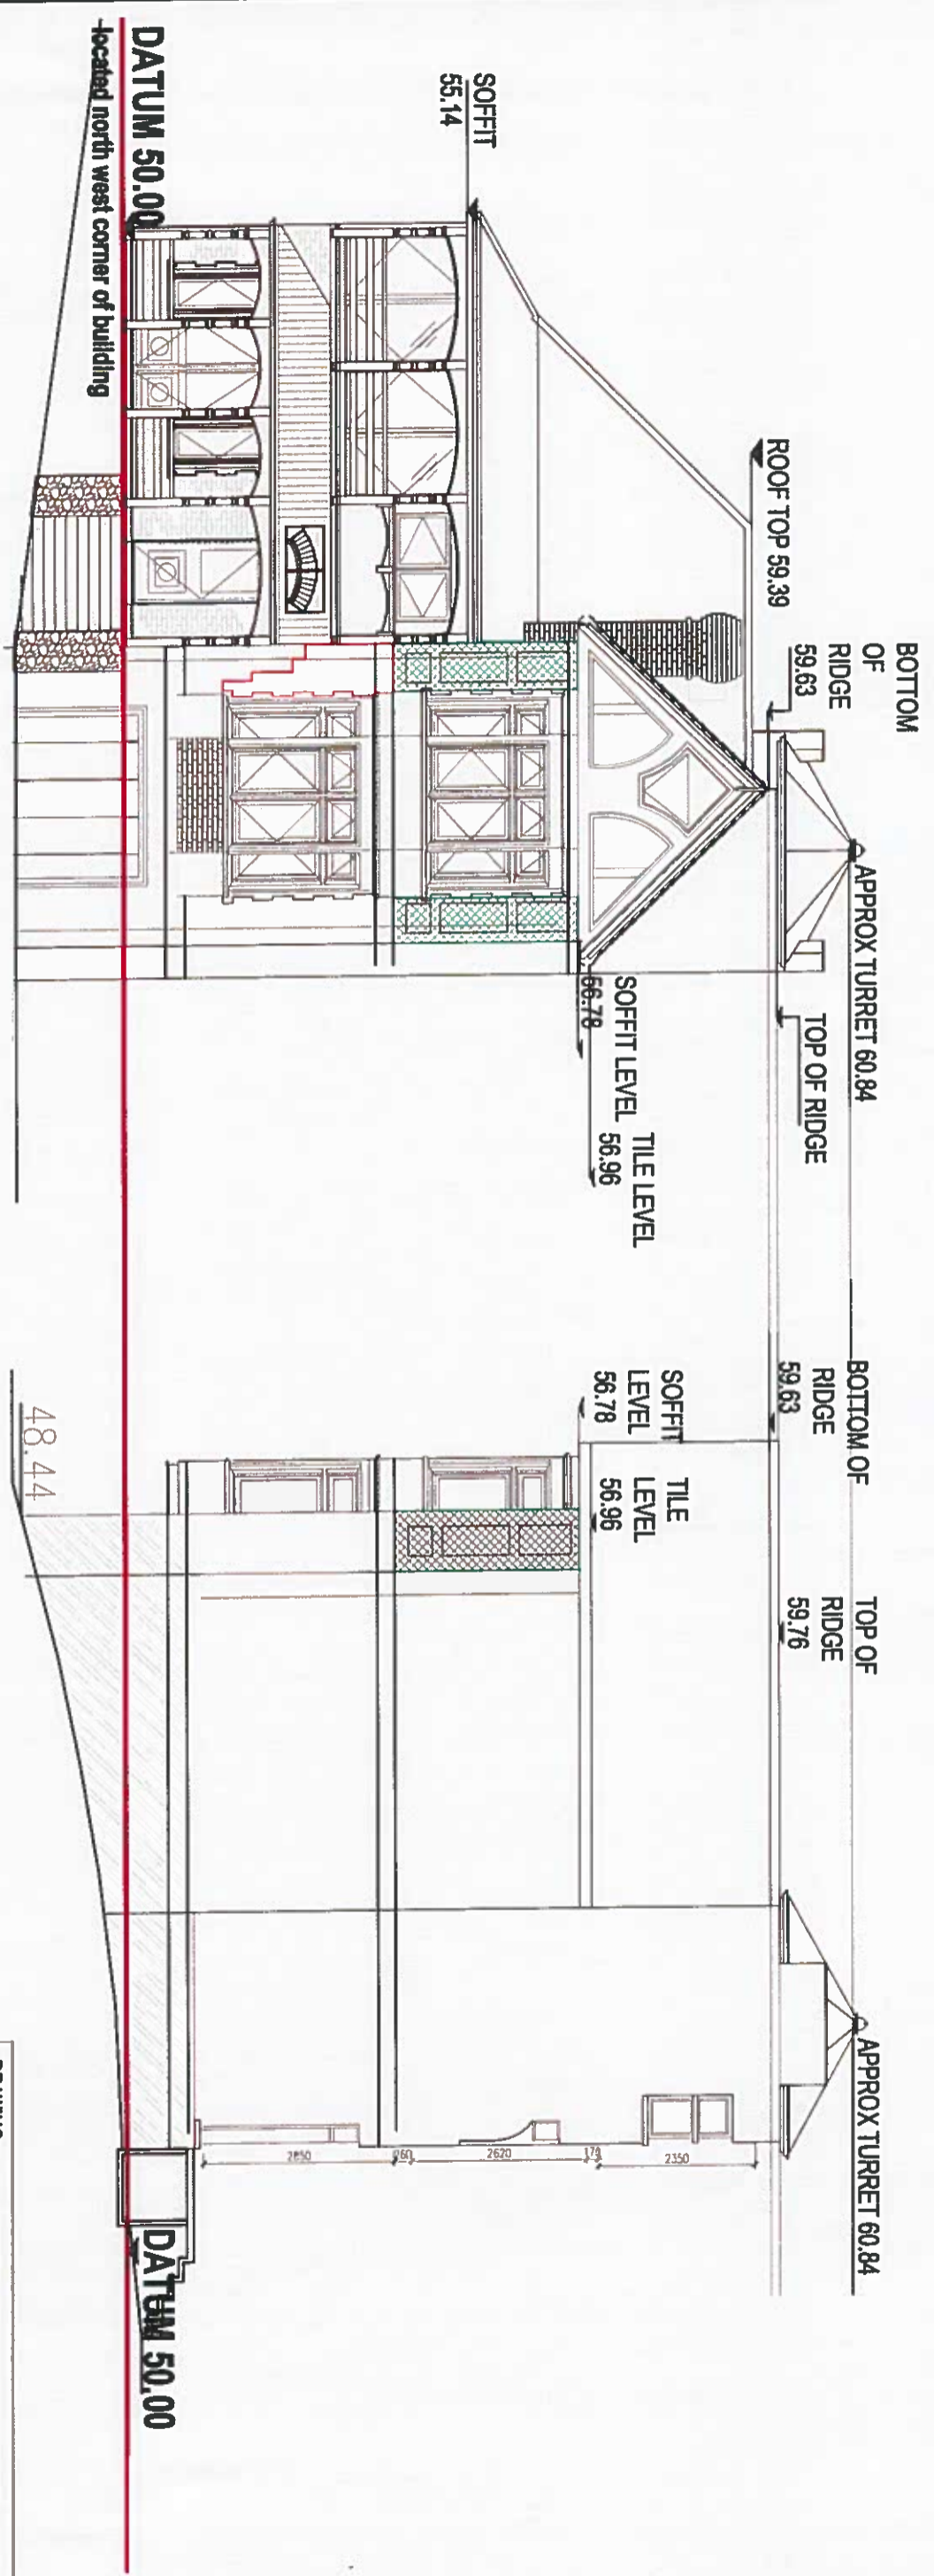

1 South Elevation - scale 1:100
P304 as built 2015/2016

1 East Elevation - scale 1:100
P304 as built 2015/2016

DRAWING: SOUTH AND EAST ELEVATION		
JOB NUMBER: 90043	DATE: 19-05-2016	
SCALE: 1:100		
DRAWN: IF	CHECKED: GL	
DRAWING_NO		
P304/P384		
PLANN	PRELIM	TENDER
		CONSTR

GLS architects

1, DOCK ROAD
ROYAL VICTORIA DOCK
LONDON, E16 1AF 1000
TEL: 020 829 7404 1000
FAX: 020 829 7473 0377
Copyright Reserved
Architects, Interiors, Designing & Planning