



- NOTES
1. THIS DRAWING IS TO BE READ IN CONJUNCTION WITH ALL RELEVANT ARCHITECTS AND ENGINEERS DRAWINGS DETAILS AND SPECIFICATION.
 2. THIS DRAWING IS NOT TO BE SCALED.

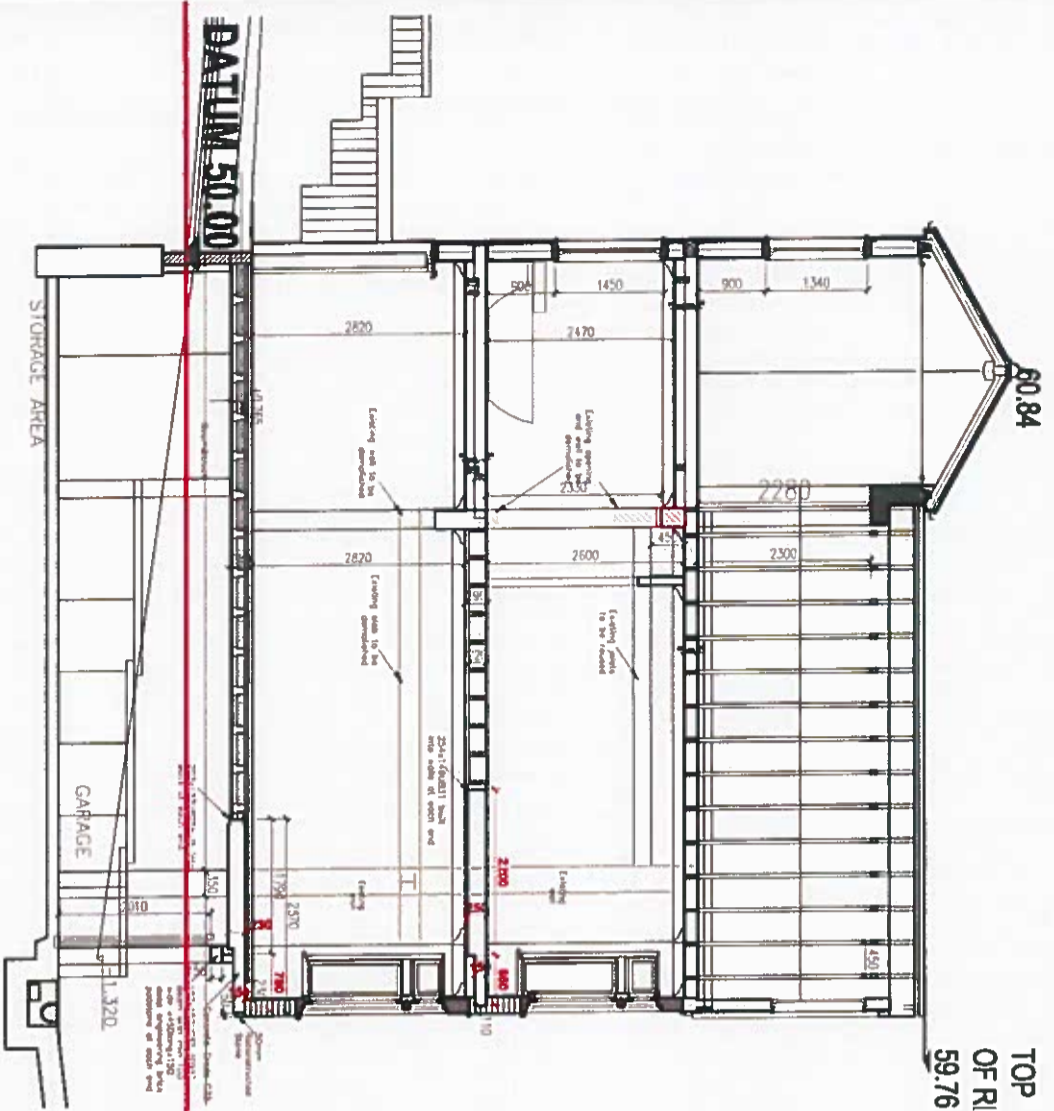

Showing built 2015/2016

1 Section CC - scale 1:100
as built 2015/2016

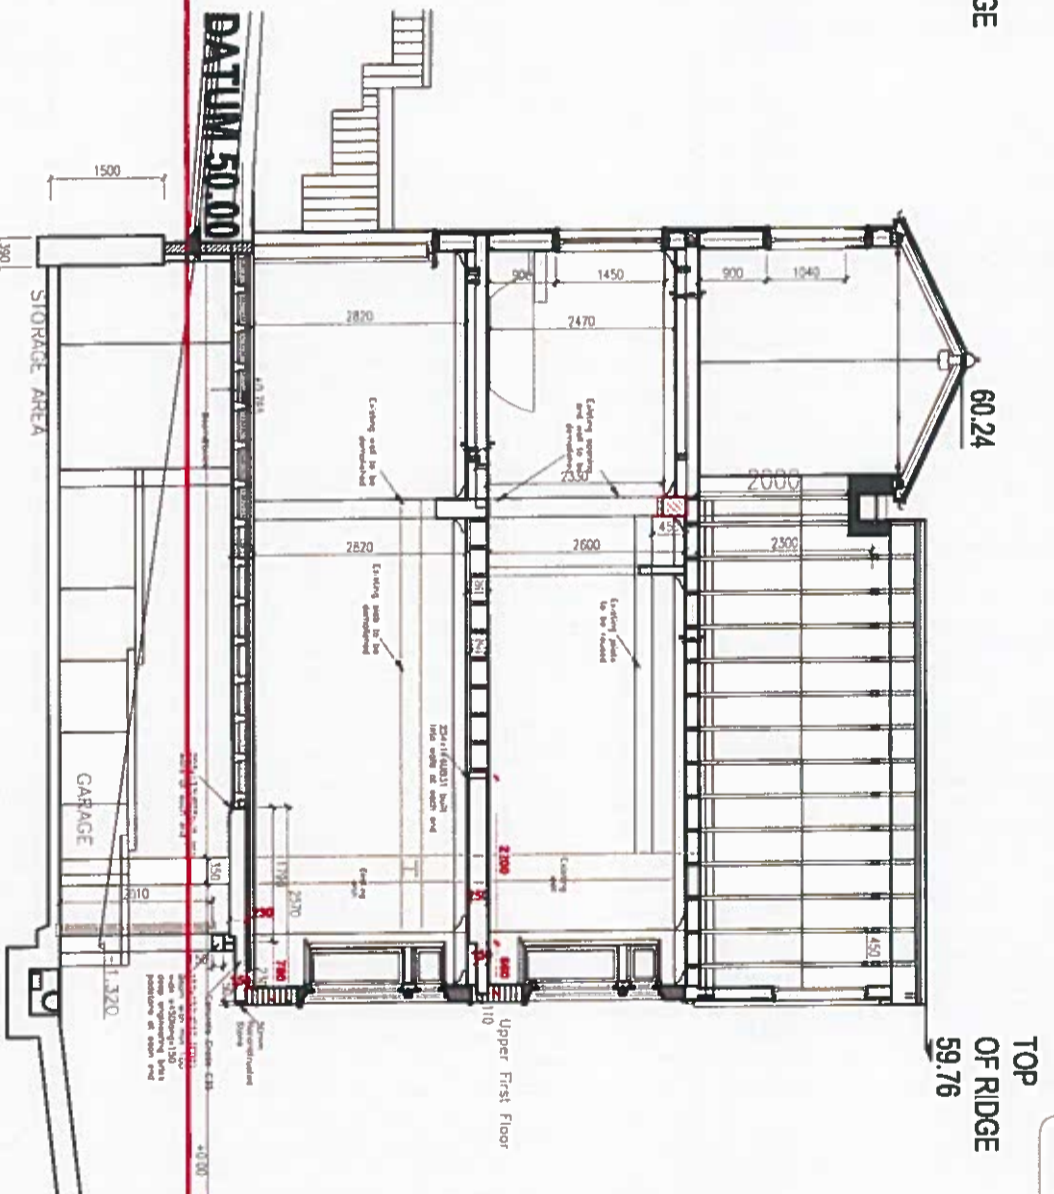

Reducing extension height to maximum but allowing a door opening height to the attic space

2 Section CC - scale 1:100
Proposal

DRAWING: SECTION		
JOB NUMBER: 90043	DATE: 19-05-2016	
SCALE: 1:100		
DRAWN: IF	CHECKED: GL	
DRAWING NO: P202		
PLANN	PRELIM	TENDER
		CONSTR

GLS architects

1 DOCK ROAD
LONDON, E16 1JY
TEL: 020 7404 1000
FAX: 020 7403 0277
Copyright Reserved
Architects, Interiors, Strategic & Planning