




3 FIRST FLOOR - scale 1:100  
Leigh Park Road  
P103

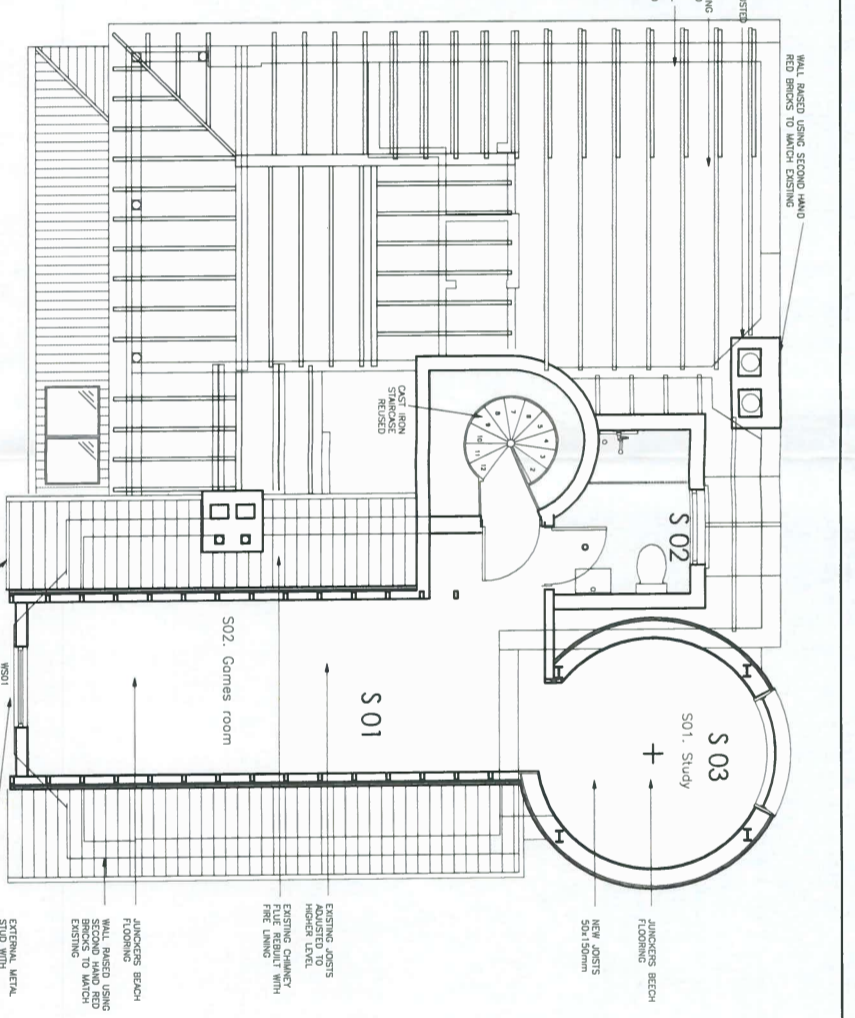


4 ATTIC FLOOR - scale 1:100  
Leigh Park Road  
P103

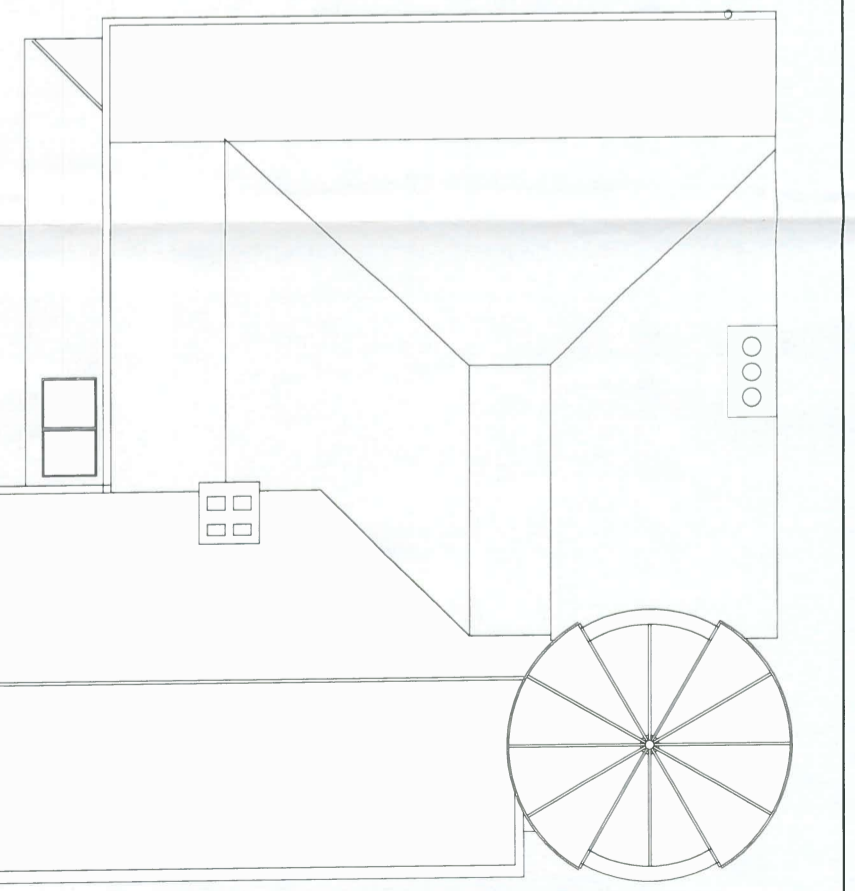

5 ROOF - scale 1:100  
Leigh Park Road  
P103

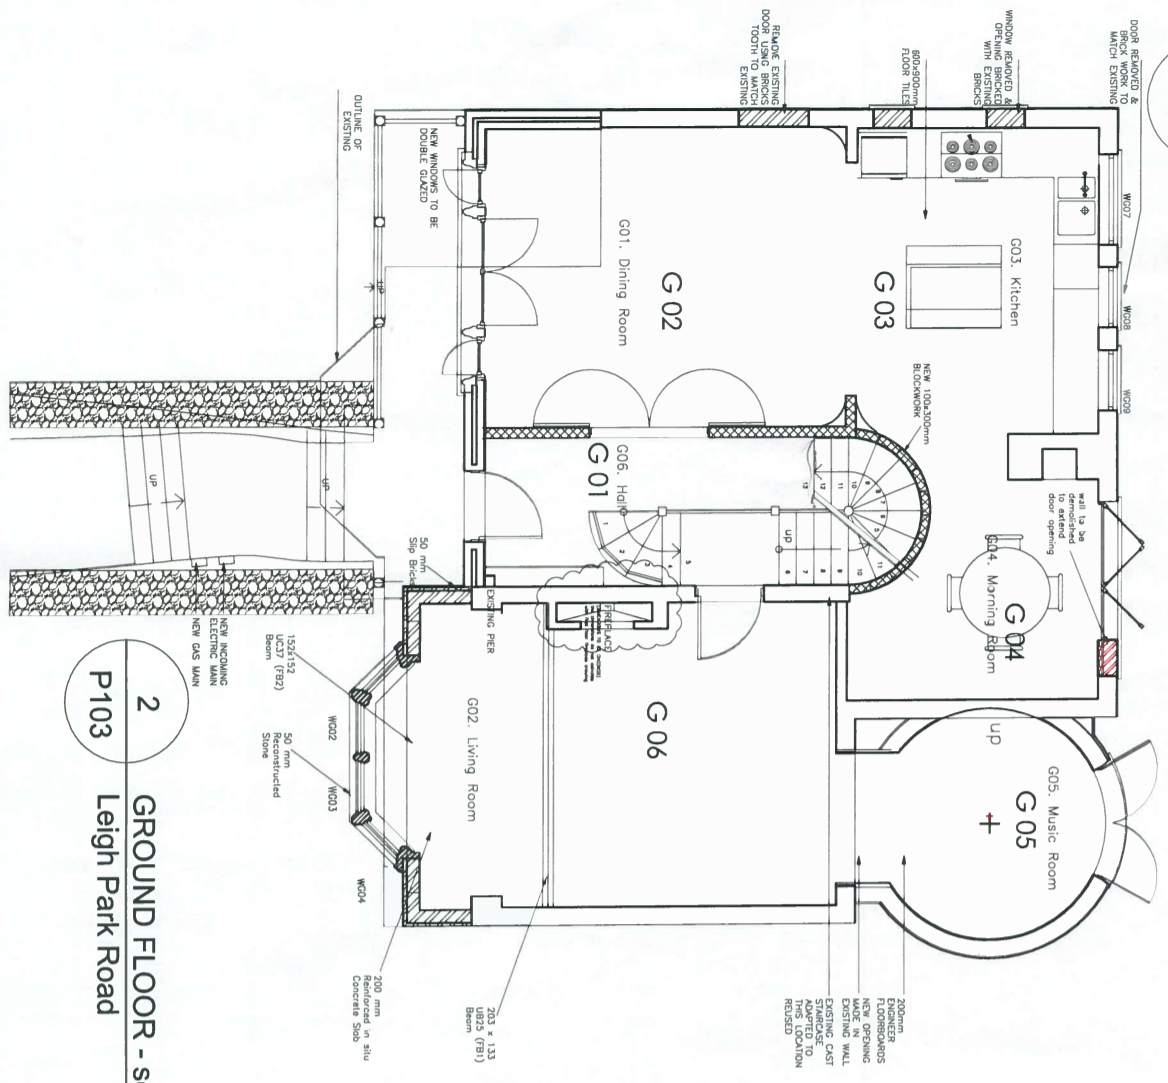

2 GROUND FLOOR - scale 1:100  
Leigh Park Road  
P103

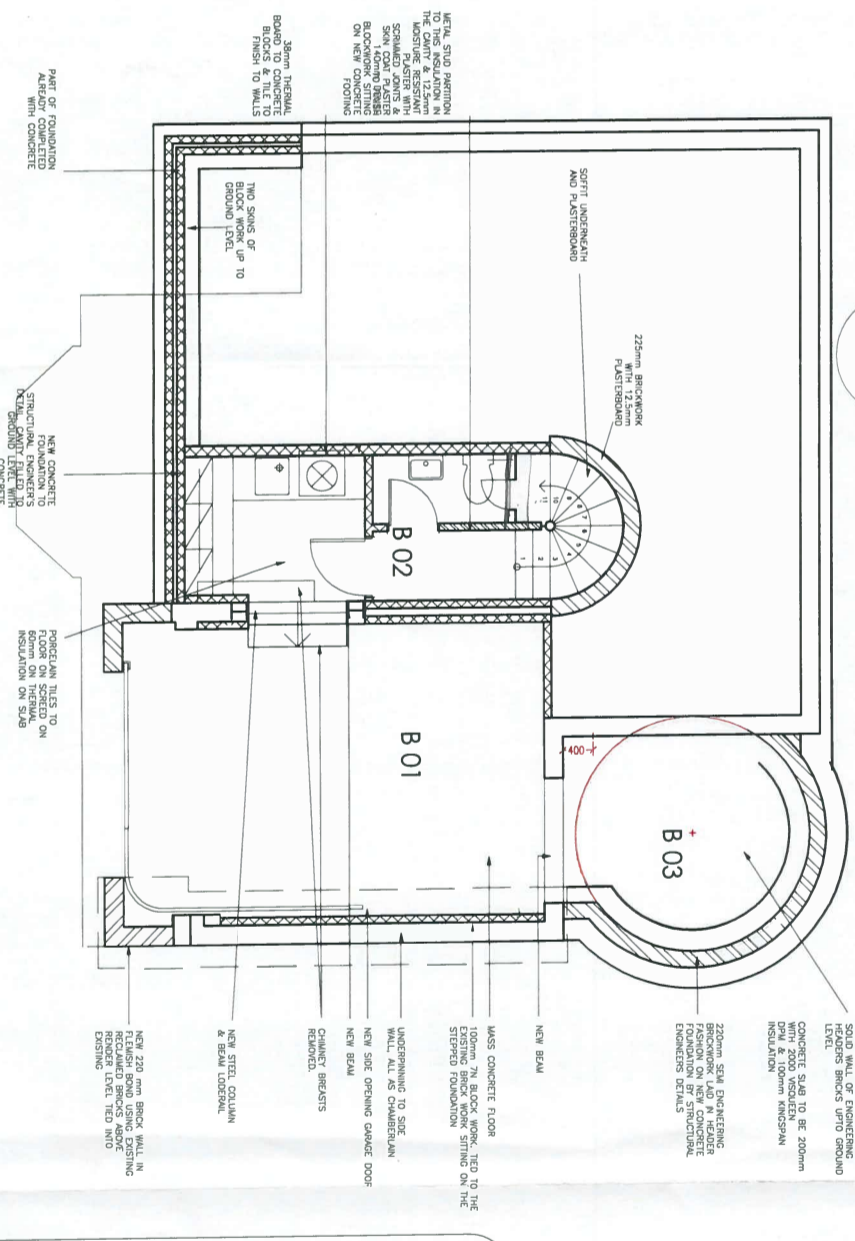

1 BASEMENT - scale 1:100  
Leigh Park Road  
P103

- NOTES
1. All dimensions to be checked and confirmed on site.
  2. All discrepancies are to be reported to and resolved by the Architects before works are commenced.
  3. This drawing is not to be scaled; occurrences with the brick and materials to be in accordance with the British Standards to be to be in accordance with all relevant codes of practice and British Standards.

Drawing **PLANS**

Client: **EZRALITTLER**

Job: **LEIGH PARK ROAD**

Dwg. No: **P103** Job No: **90043** Scale: **1:100** Date: **08/10/2015**

1 DOCK ROAD  
WATERFRONT STUDIOS  
LONDON, E16 2AN 1000  
FAXNO: 020 7404 0500  
enquiries@easarchitects.co.uk  
Copyright Reserved  
Architecture, Interiors, Surveying & Planning

