


- NOTES
1. THIS DRAWING IS TO BE READ IN CONJUNCTION WITH ALL RELEVANT ARCHITECTS AND ENGINEERS DRAWINGS DETAILS AND SPECIFICATION.
  2. THIS DRAWING IS NOT TO BE SCALED.

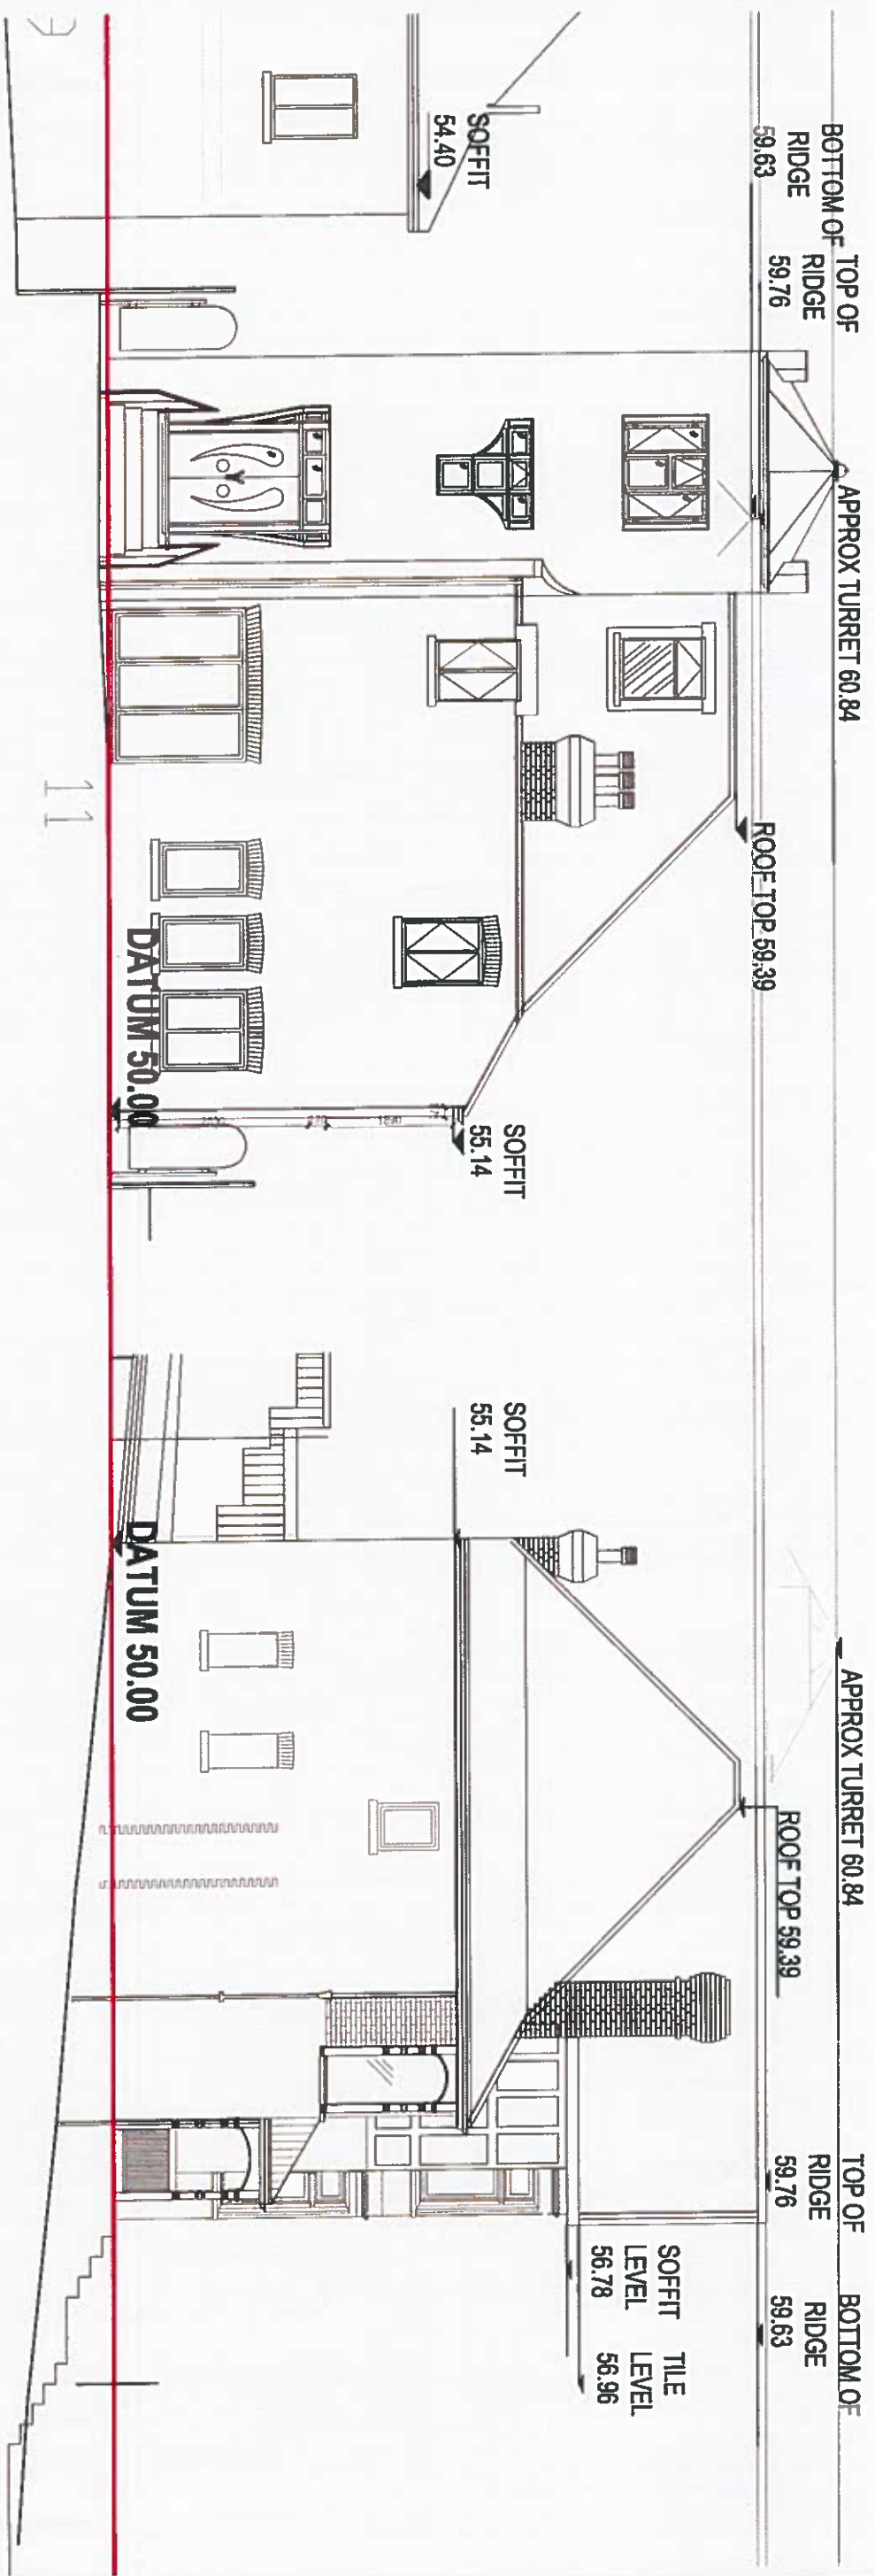

1 North elevation - scale 1:100  
P305 as built 2016/2016

1 West elevation - scale 1:100  
P306 as built 2016/2016

**DRAWING: NORTH AND WEST ELEVATION**

JOB NUMBER: 90043	DATE: 19-05-2016	
SCALE: 1:100		
DRAWN: IF	CHECKED: GL	
DRAWING_NO: P383/P305		
PLANN	PRELIM	TENDER
		CONSTR

**GDS architects**

1 ROCK ROAD  
ROCKVIEW, QLD 4074  
PH: 07 550 7400  
FAX: 07 550 7401  
WWW.GDSARCHITECTS.COM

Copyright Reserved  
All Rights Reserved  
Reproduction, Storage, Copying & Printing