


This drawing is copyright and shall not be reproduced or used for any other purpose without written permission of the author.
 Do not scale from this drawing, use figured dimensions only.
 The drawing must be read in conjunction with all other project related drawings and documentation issued by the Architect and Appointed Consultants.
 It is the contractor's responsibility to ensure compliance with the Building Regulations.
 It is the contractor's responsibility to check all dimensions on site, any discrepancy to be reported immediately.
 Details and sizes shown are indicative only and are subject to confirmation by the relevant Specialist contractor & sub-contractors.
 This drawing is not to be used for Land Registry or sales purposes.
 The Author is not responsible for any changes to the drawings as implemented on site without prior approval in writing.

Revision: _____ Date: _____

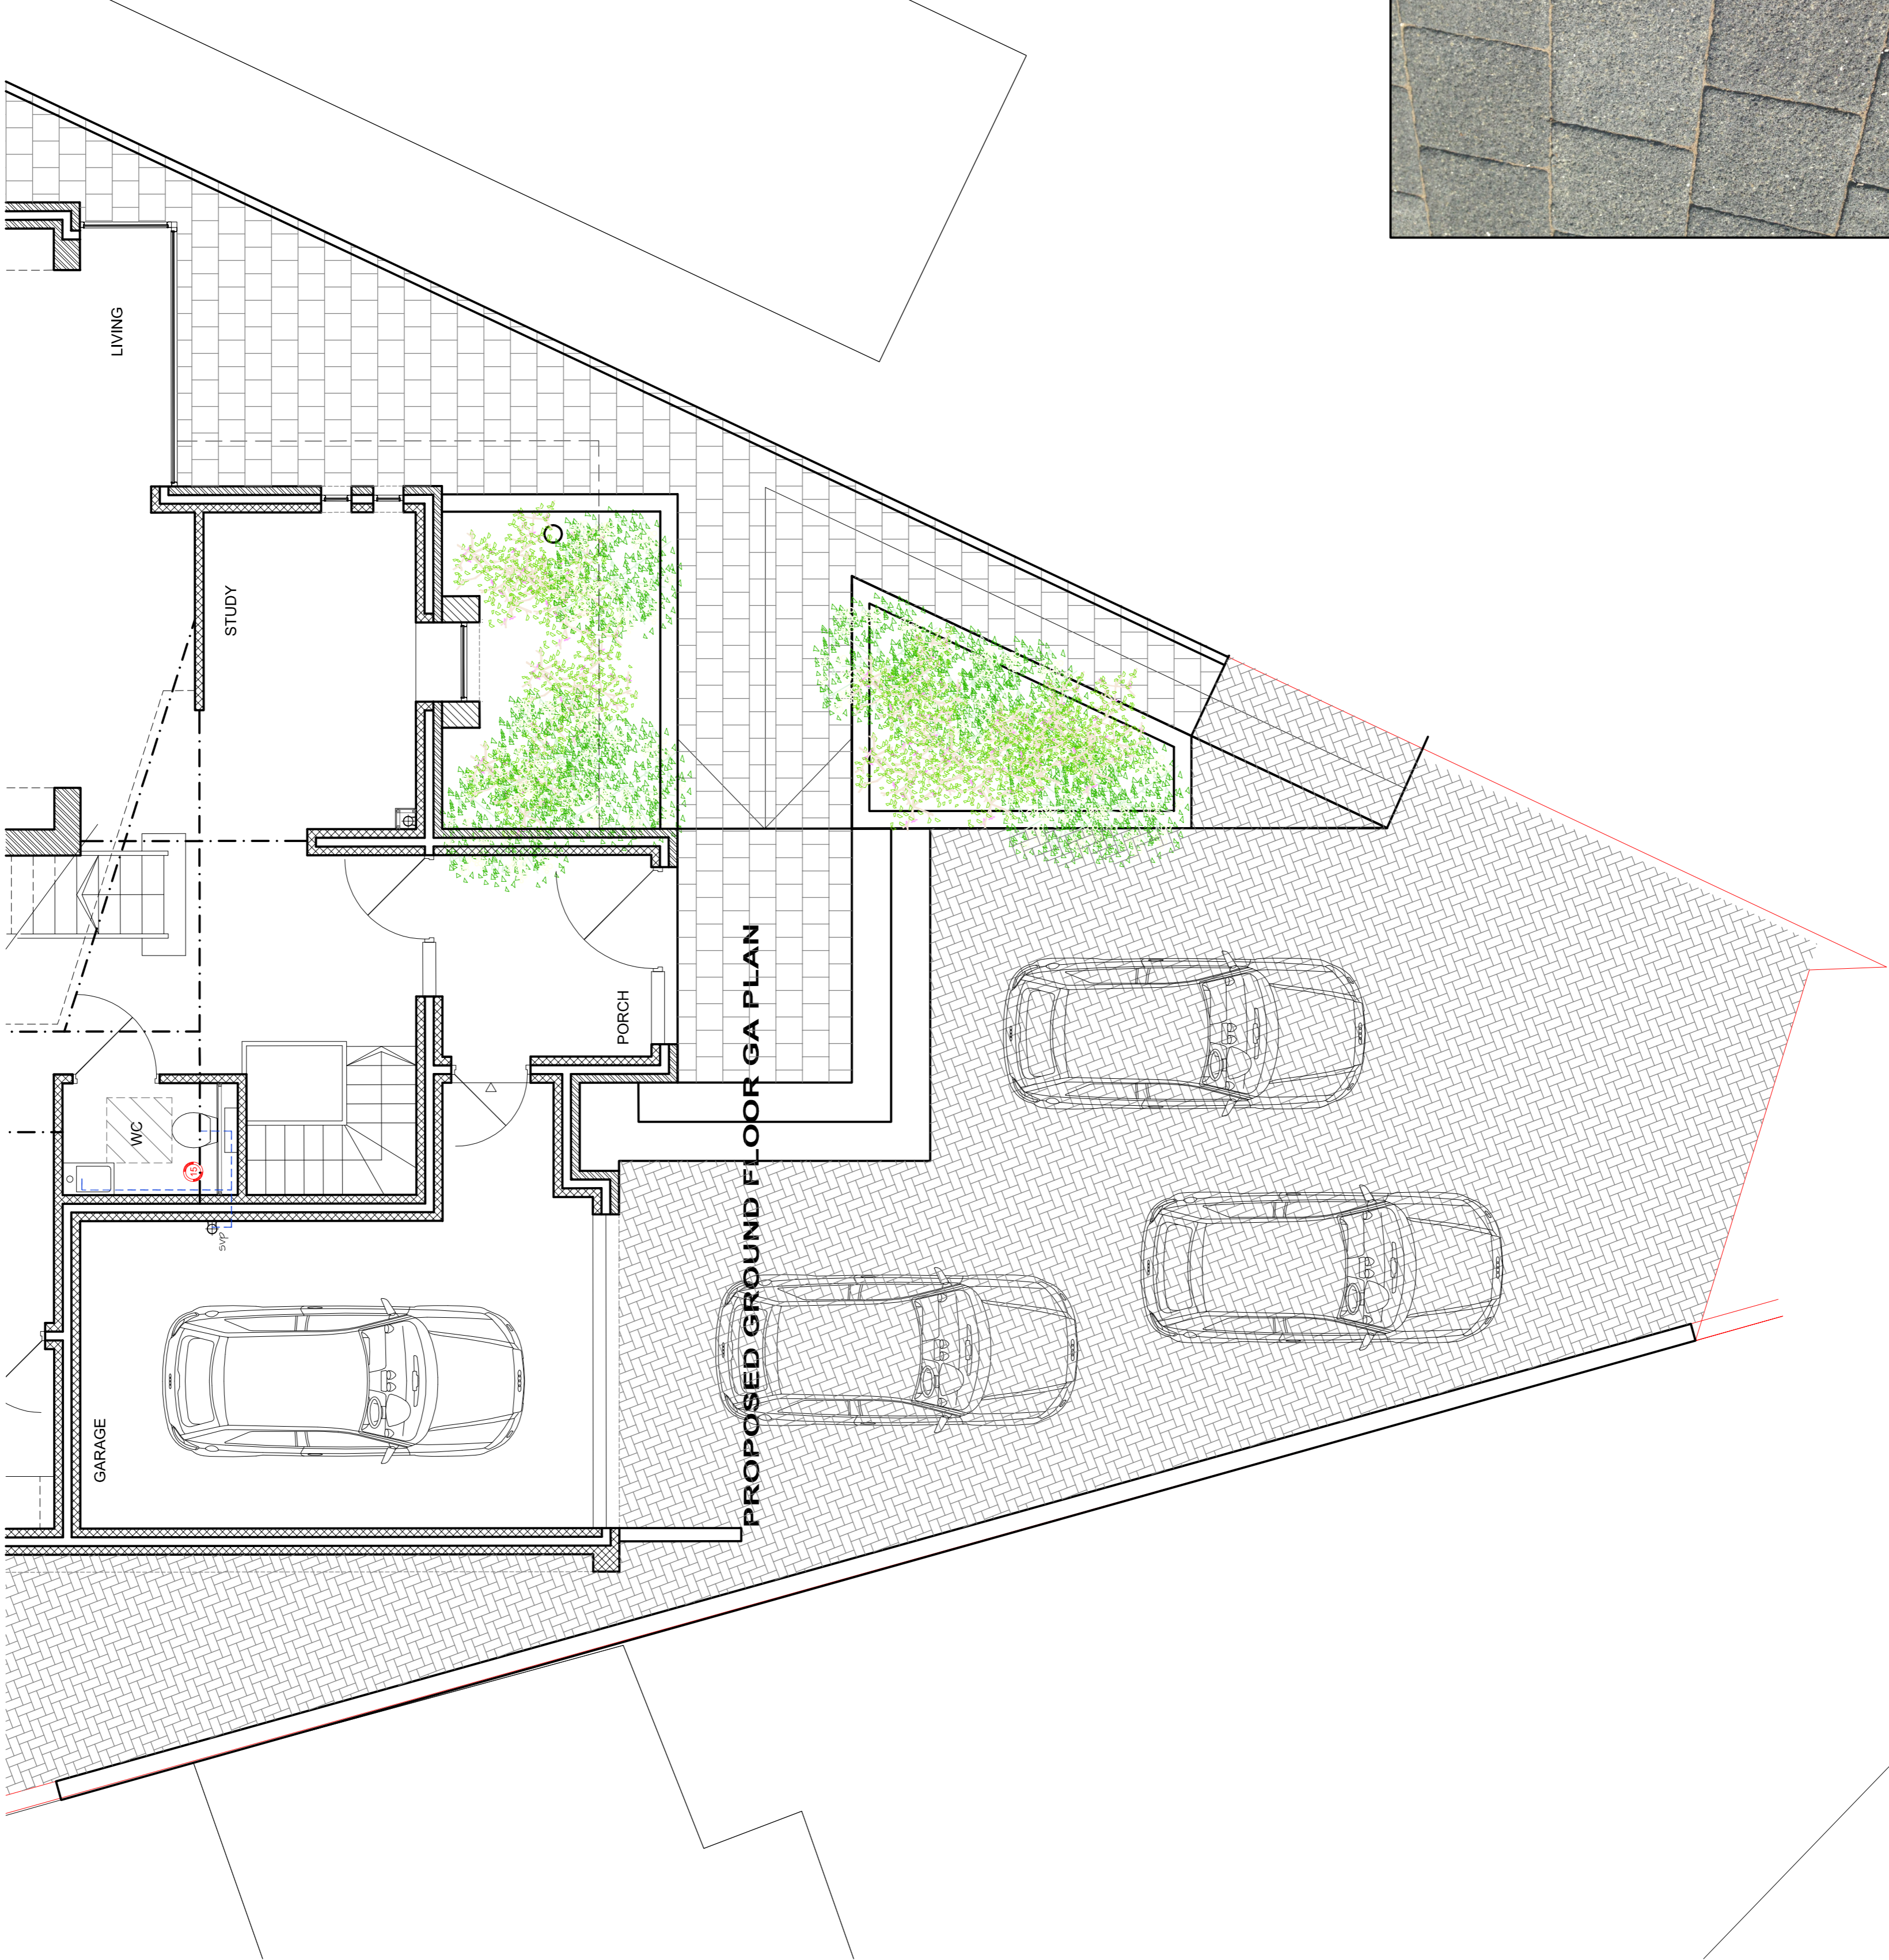

knight gratrix architects
 upper studio
 12 Broadway
 Knighton
 Essex
 SS9 1AB
 t 01702 715517
 f 01702 480492
 e mail@knightgratrix.com
 w www.knightgratrix.com

Client: Mr & Mrs Collins
Project: 12 Marine Close
Description: New Build House
 As built drawings and photos
 Discharge of conditions

Scheme	Planning	Drawn	pd/alk	Date	Sept 16
Scale	1:50	Drawn by	pd/alk	Revision	031
Job number	626	Drawings no.			