

Southend on Sea Borough Council

Enterprise, Tourism
and the Environment
PO Box 5560, Civic Centre
Victoria Avenue, Southend on Sea,
SS2 6ZQ

Project Title
Parking Review - Plan 1

Drawing Title
**Kingswood Chase Original
Proposal**

Date

Quality Project No.

01

Scales

not to scale

Drawing Number

CE 1 / /


Drawing Status

Preliminary

Tender

Working

As Constructed

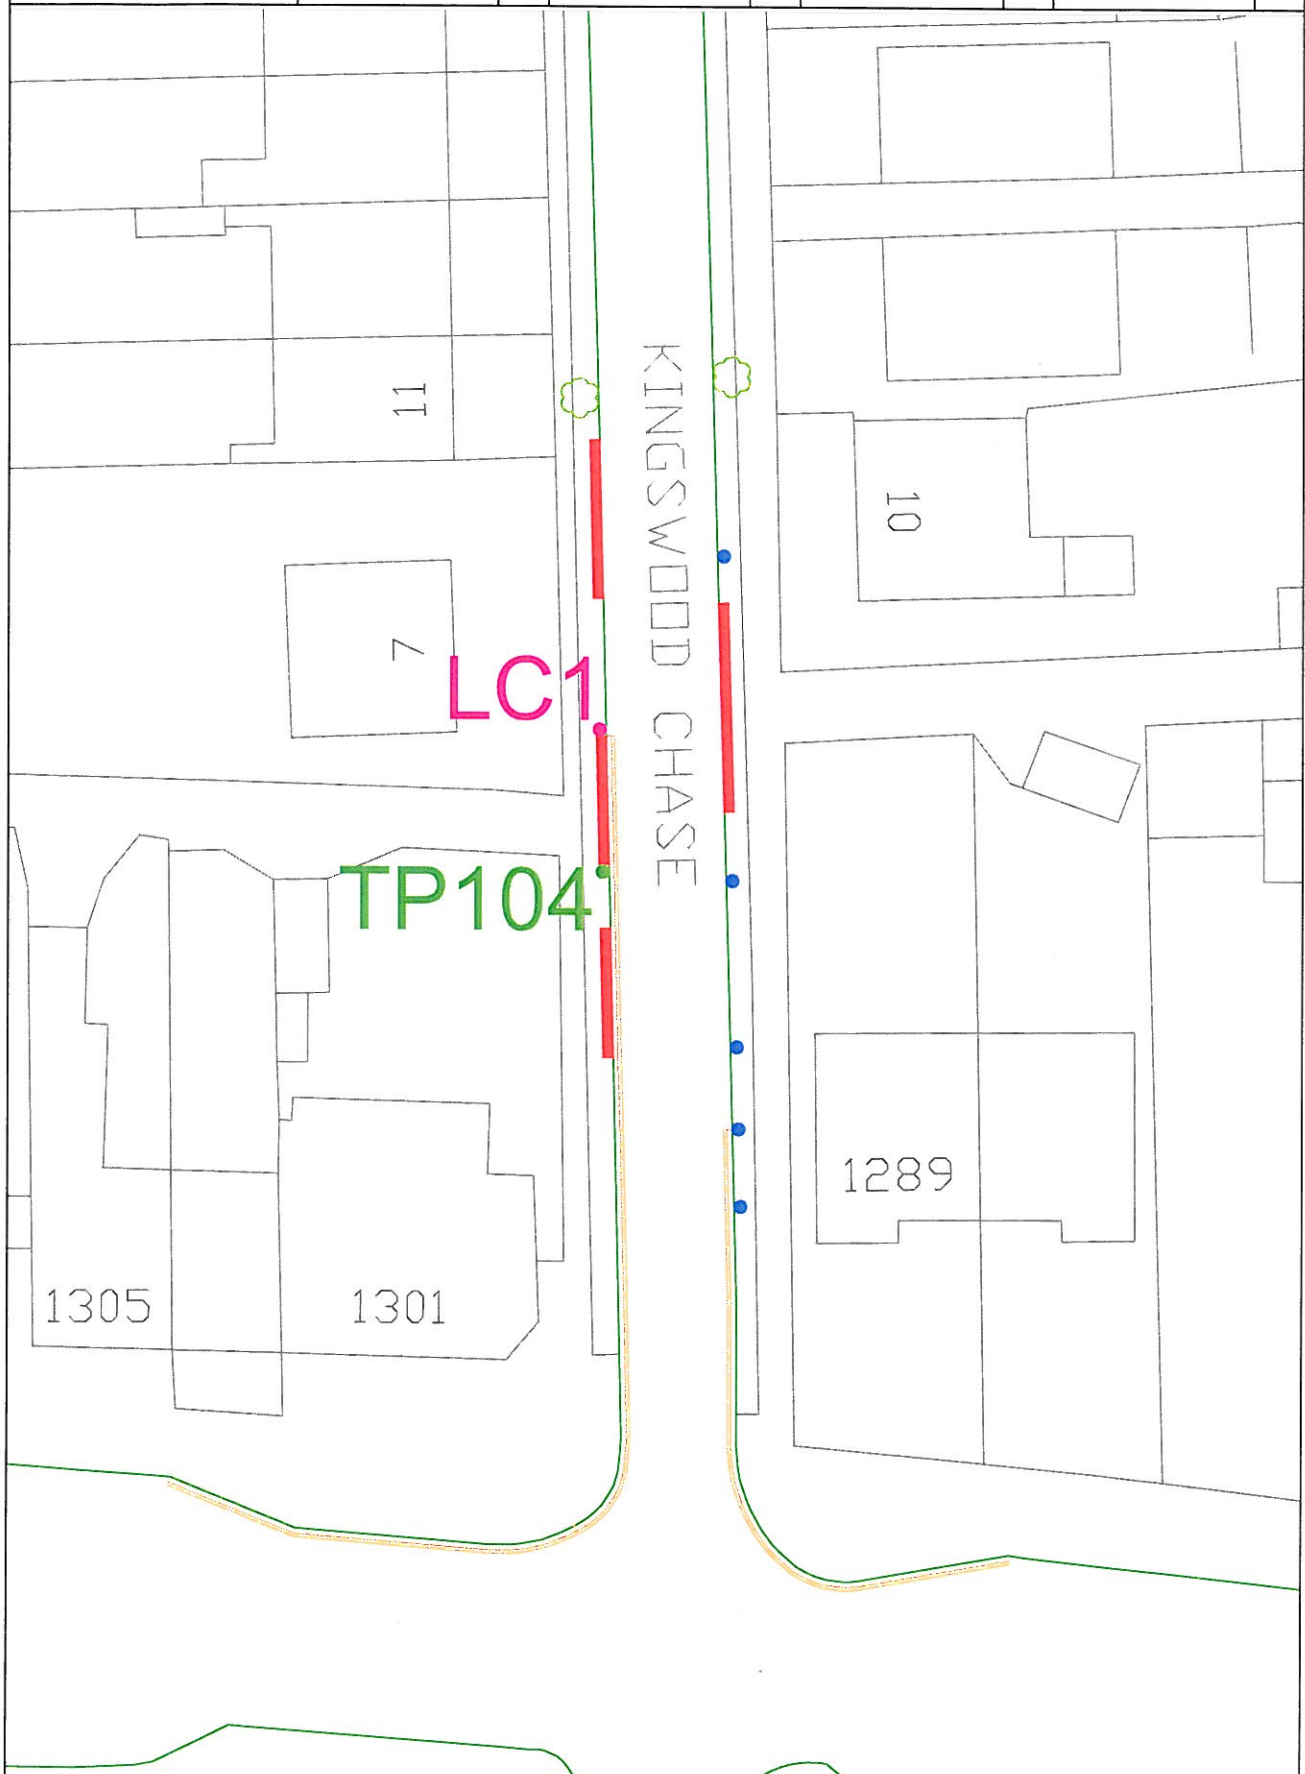

Southend on Sea Borough Council

Enterprise, Tourism
and the Environment
PO Box 5560, Civic Centre
Victoria Avenue, Southend on Sea,
SS2 6ZQ

Project Title
Parking Review - Plan 2

Drawing Title
**Manchester Drive, existing restrictions
and Proposed Amendments**

Date

Quality Project No.

02

Scales
not to scale

Drawing Number

CE 02 / /

Designed

Drawn by

Checked by

Approved by

Drawing Status

Preliminary

Tender

Working

As Constructed

House
Complex

117

109

107

**Proposed
Prohibition of
Waiting At Any
Time**

TP782

ESTER DRIVE

LC20

LC21

**Existing
Restrictions**

PLIVIA DRIVE

72

136

132

68

73

69

Southend on Sea Borough Council
 Enterprise, Tourism
 and the Environment
 PO Box 5560, Civic Centre
 Victoria Avenue, Southend on Sea,
 SS2 6ZQ

Project Title
 Parking Review Plan 3

Date

Drawing Title
 Finchley Road/Cranley Road
 Original and Amended Proposal

Quality Project No.

03

Scales
 not to scale

Designed

Drawn by

Checked by

Approved by

Drawing Number

CE 03 / /


Drawing Status

Preliminary



Tender

Working

As Constructed

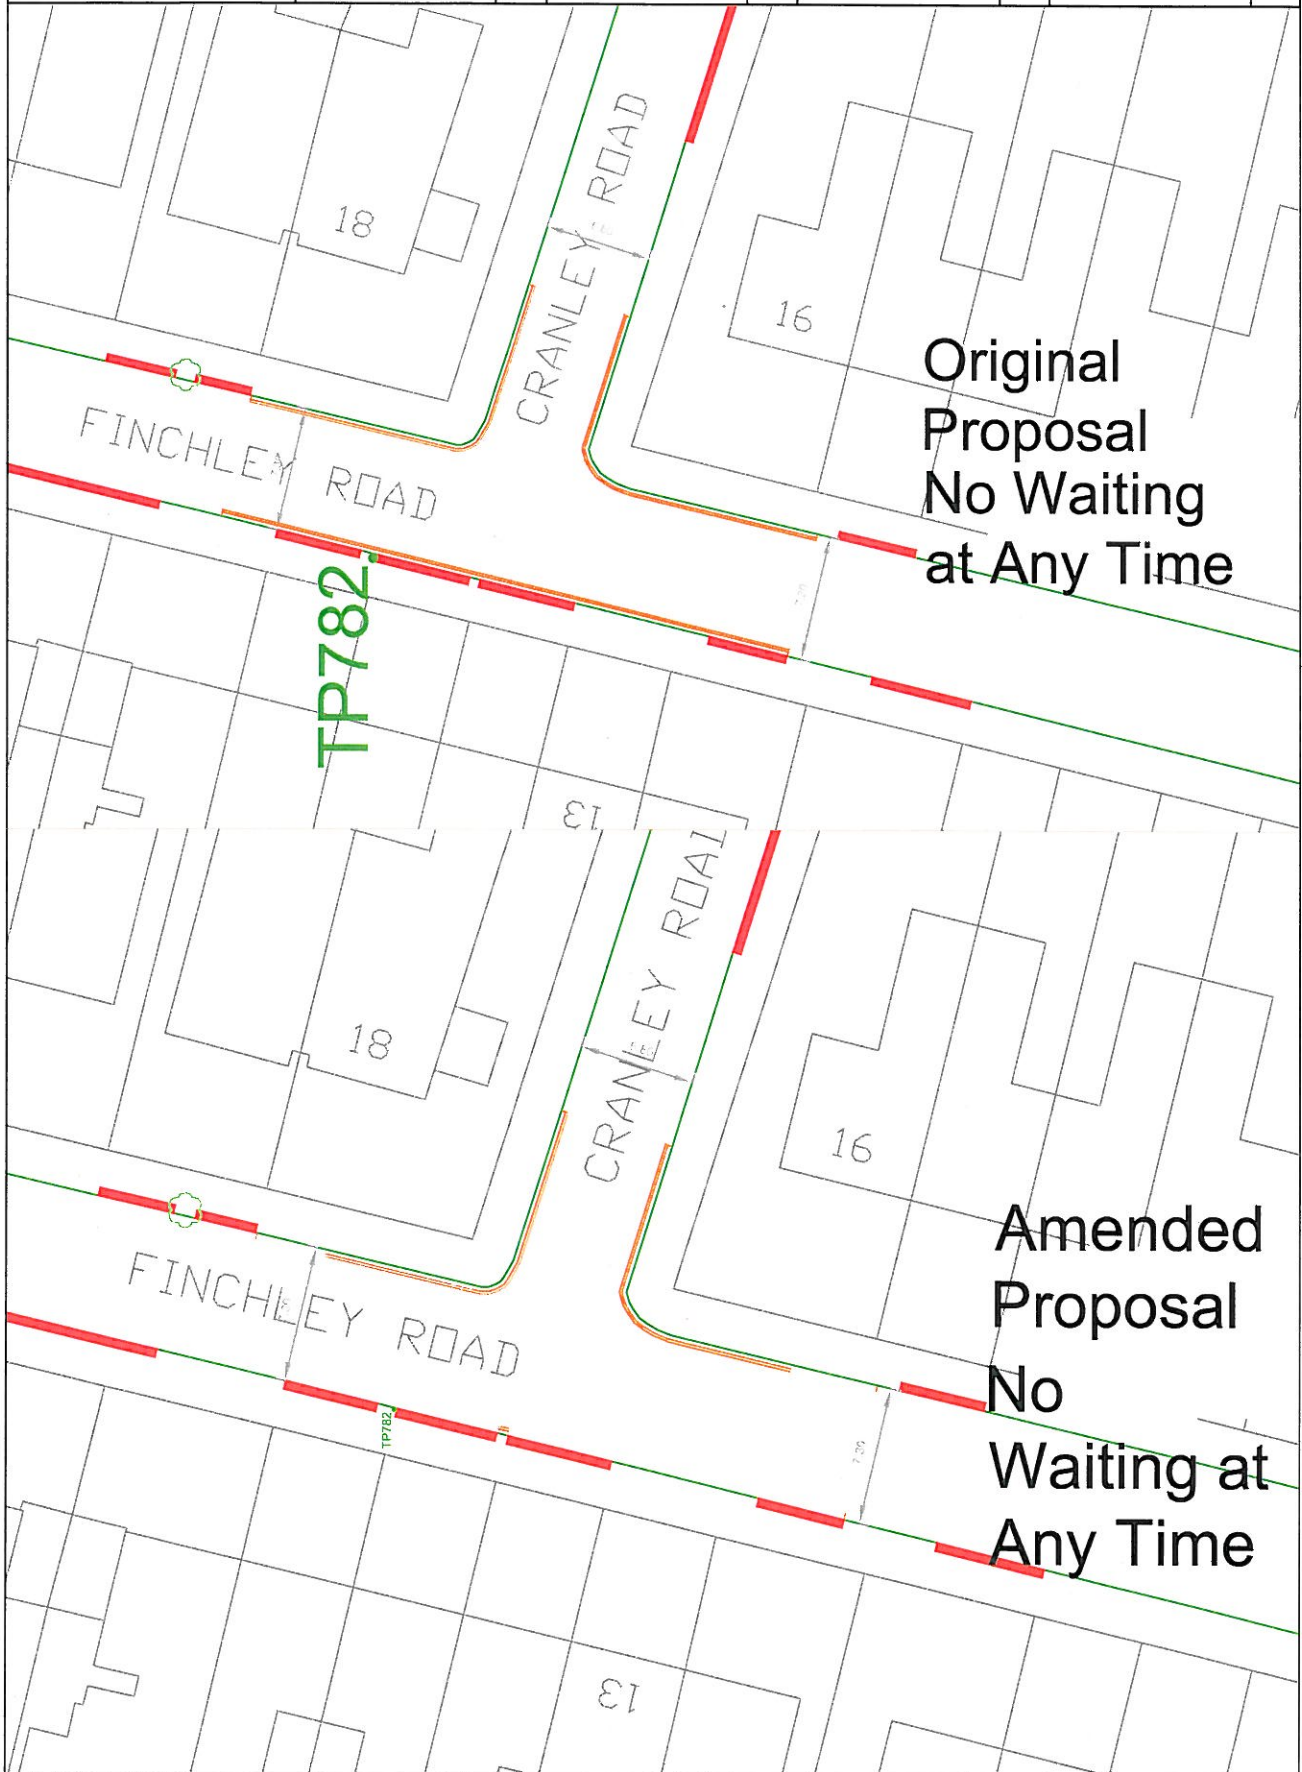


Southend on Sea Borough Council Enterprise, Tourism and the Environment PO Box 5560, Civic Centre Victoria Avenue, Southend on Sea, SS2 6ZQ		Project Title Parking Review - Plan 4		Date		
		Drawing Title Burges Road/Burges Terrace Original and Proposed Amendments		Quality Project No. 04		
		Designed	Drawn by	Checked by	Approved by	Scales not to scale
				Drawing Number CE 04 / /		
Drawing Status	Preliminary		Tender		Working	As Constructed

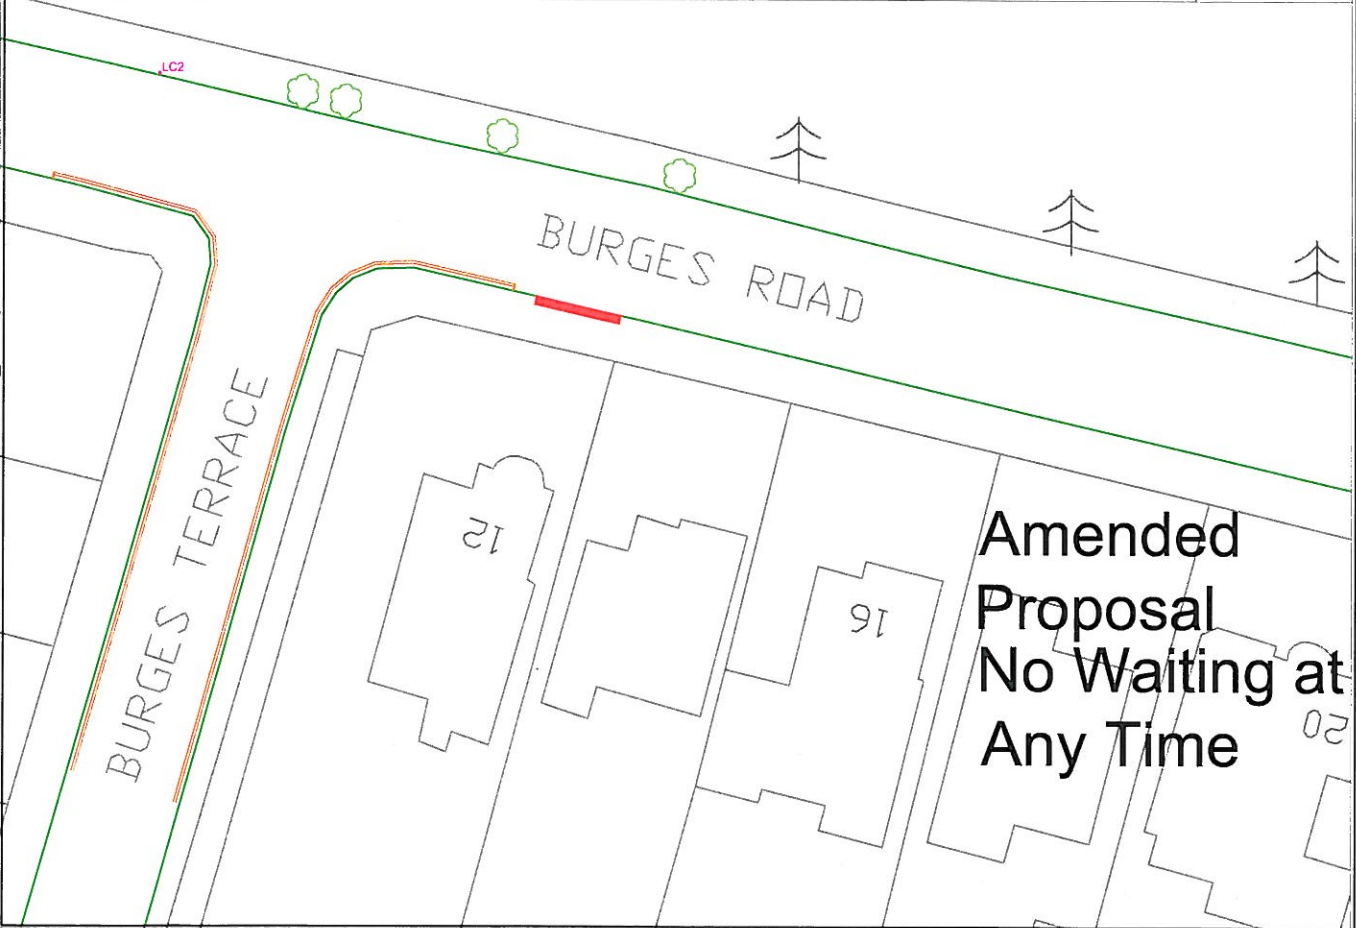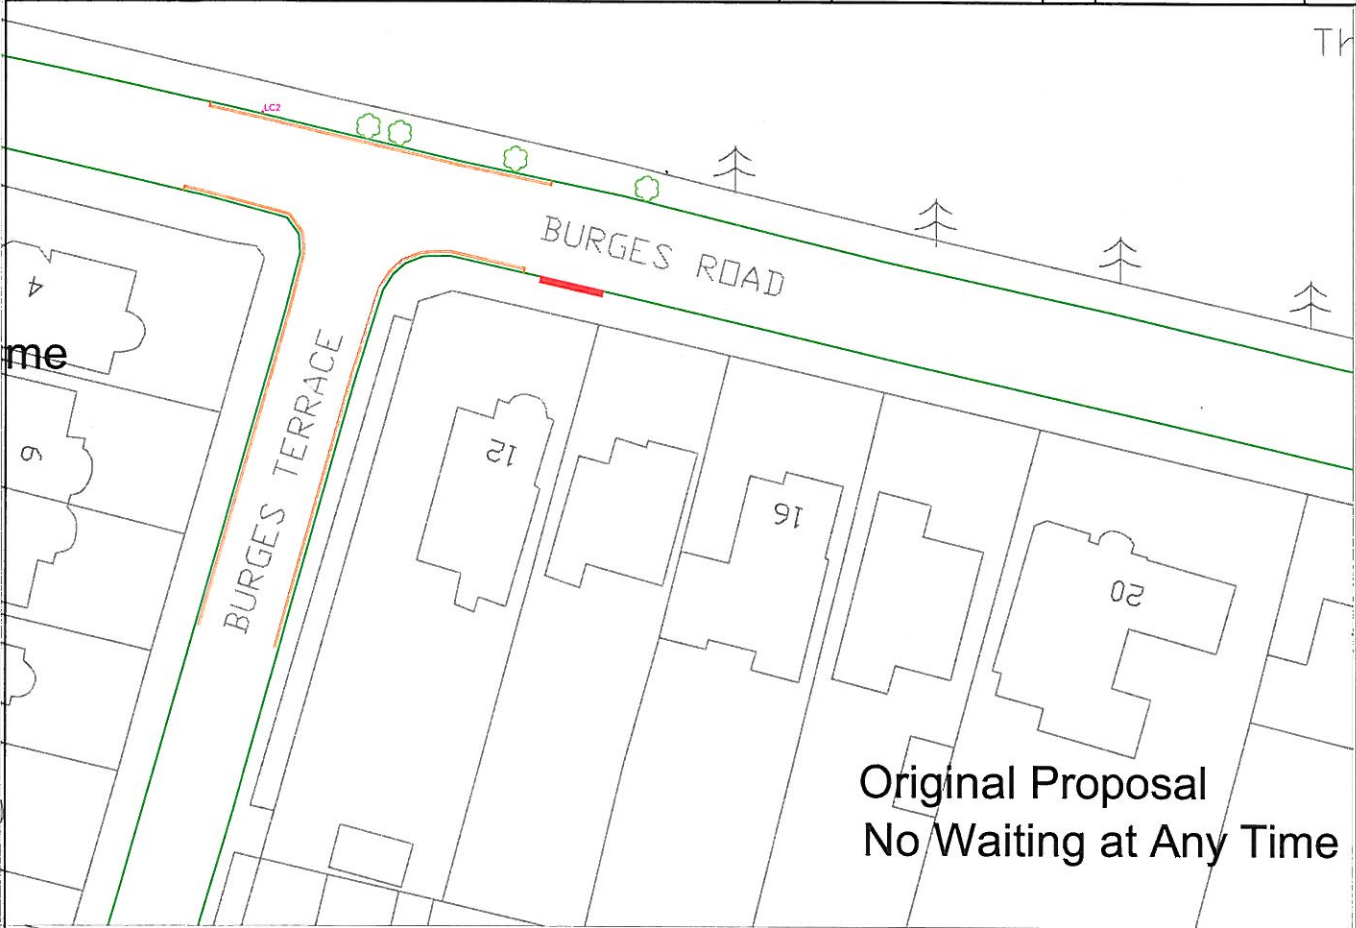


Southend on Sea Borough Council Enterprise, Tourism and the Environment PO Box 5560, Civic Centre Victoria Avenue, Southend on Sea, SS2 6ZQ	Project Title Parking Review - Plan 5			Date
	Drawing Title Colbert Avenue/Lynton Road			Quality Project No. 05
	Original and Proposed Amendments			Scales not to scale
	Designed	Drawn by	Checked by	Approved by
				Drawing Number CE 05 / /

Drawing Status	Preliminary	Tender	Working	As Constructed
-----------------------	-------------	--------	---------	----------------

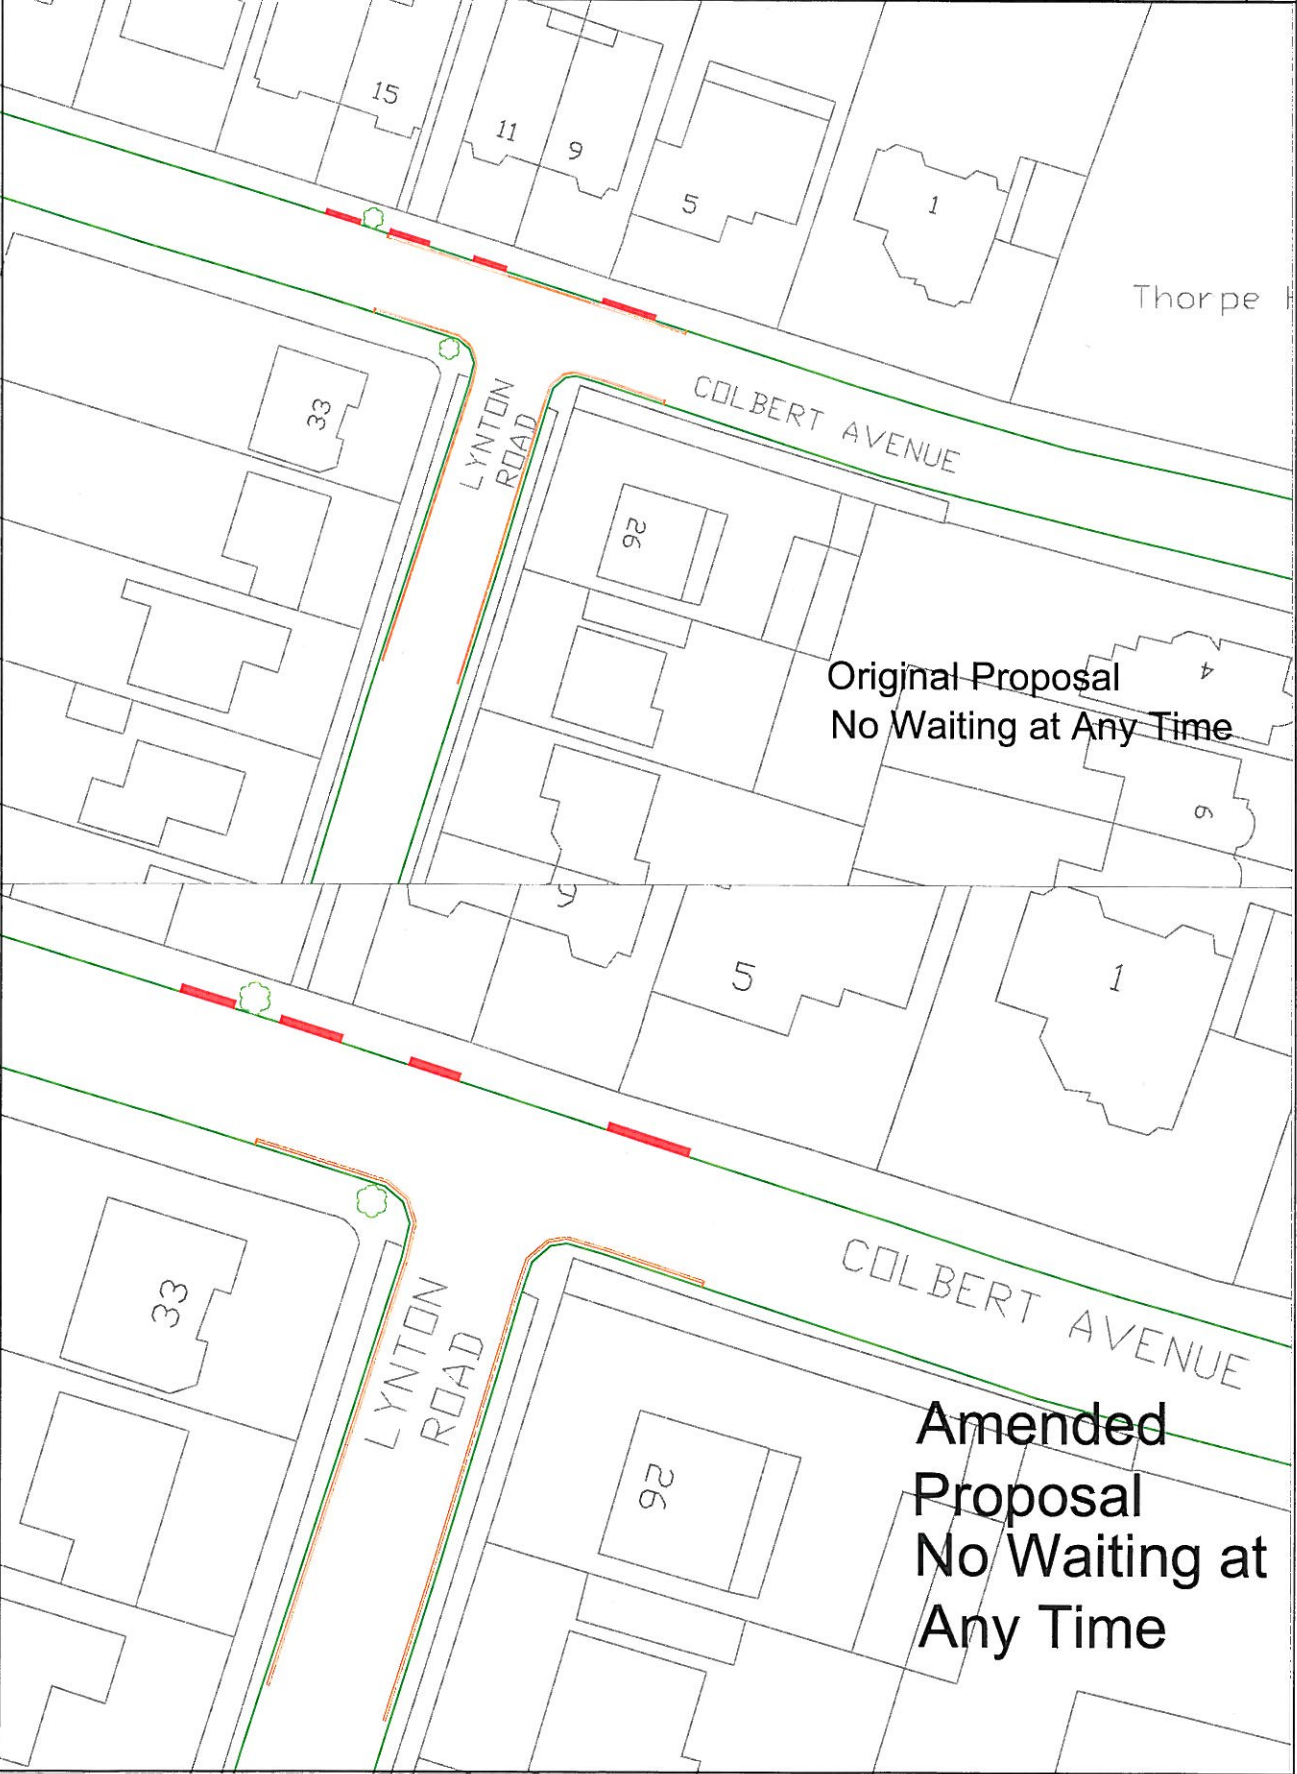



Southend on Sea Borough Council Enterprise, Tourism and the Environment PO Box 5560, Civic Centre Victoria Avenue, Southend on Sea, SS2 6ZQ	Project Title Parking Review - Plan 6			Date
	Drawing Title Colbert Avenue/Walton Road			Quality Project No. 06
	Original and Proposed Amendments			Scales not to scale
Designed	Drawn by	Checked by	Approved by	Drawing Number CE 06 / /

Drawing Status	Preliminary	Tender	Working	As Constructed
-----------------------	-------------	--------	---------	----------------


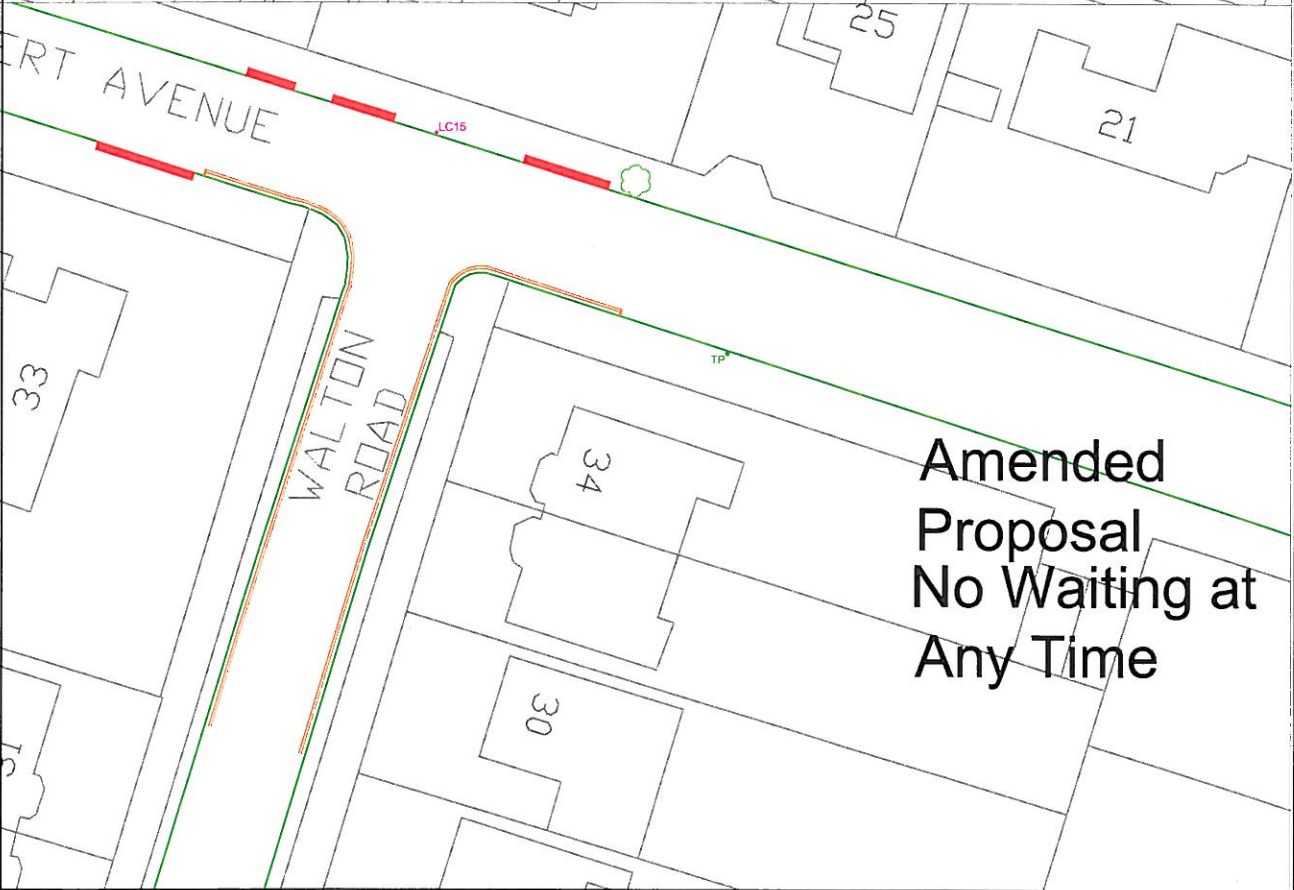


Southend on Sea Borough Council Enterprise, Tourism and the Environment PO Box 5560, Civic Centre Victoria Avenue, Southend on Sea, SS2 6ZQ	Project Title Parking Review - Plan 7			Date
	Drawing Title Colbert Avenue/Clieveden Road			Quality Project No. 07
	Original and Proposed Amendments			Scales not to scale
	Designed	Drawn by	Checked by	Approved by
				Drawing Number CE 07 / /

Drawing Status	Preliminary		Tender		Working		As Constructed
-----------------------	-------------	--	--------	--	---------	--	----------------

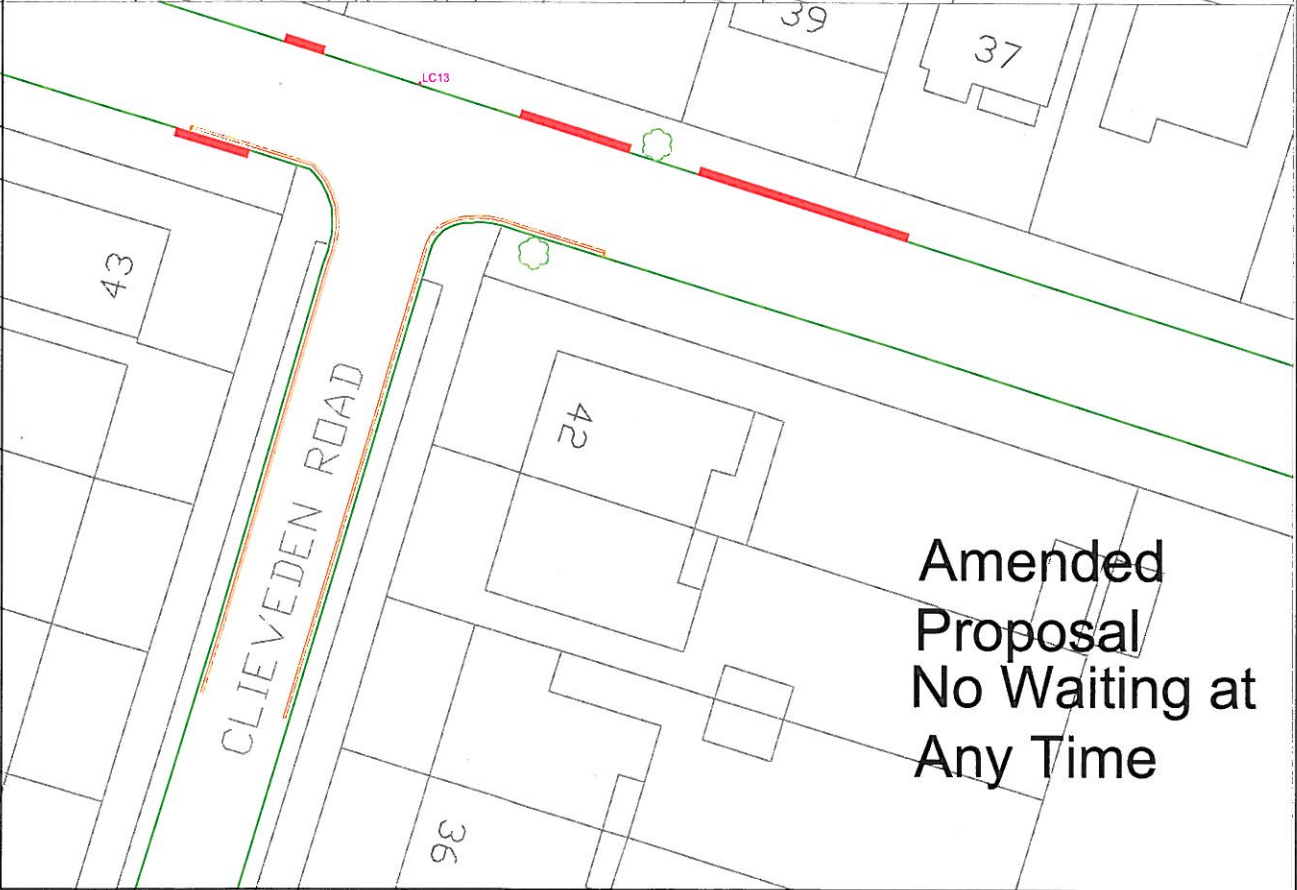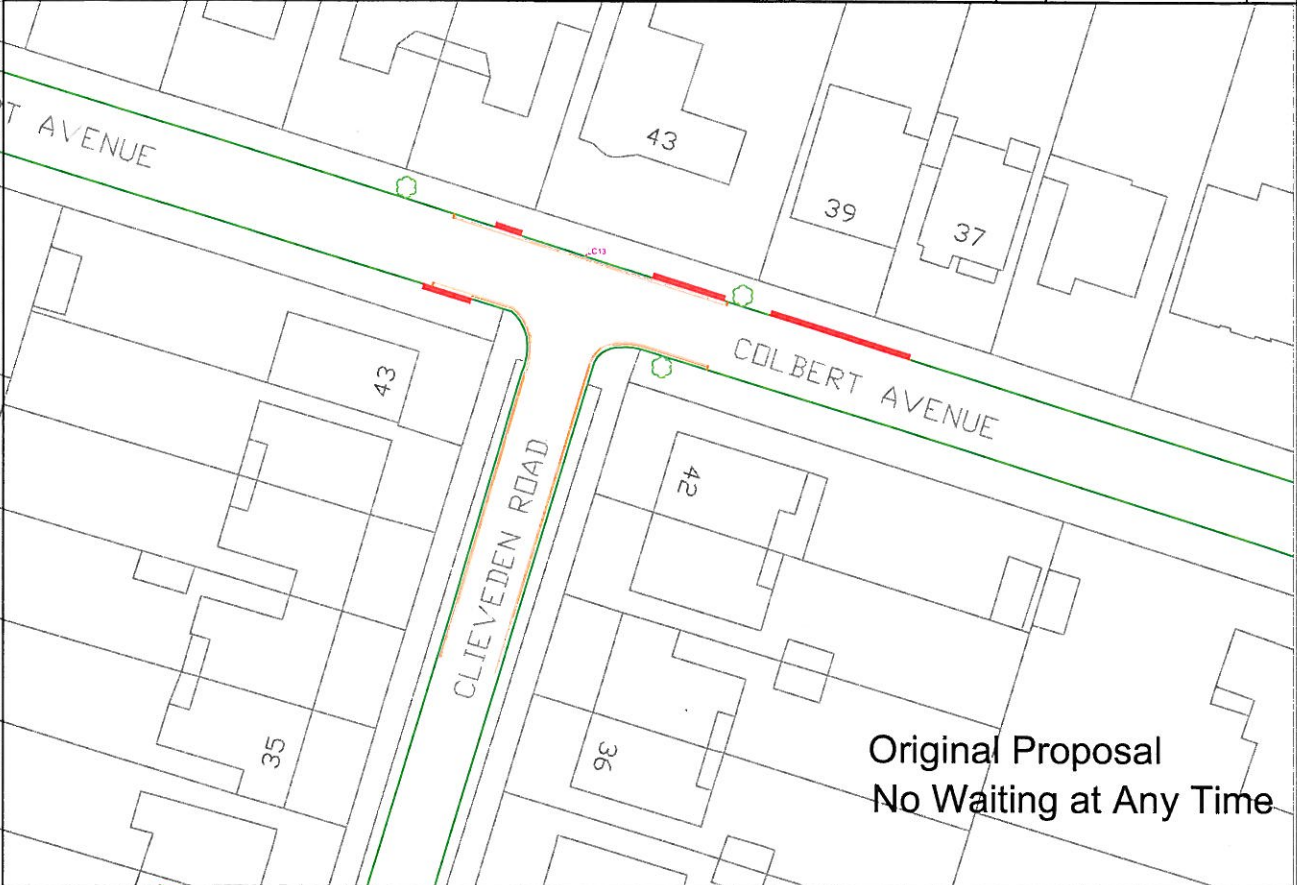

Southend on Sea Borough Council Enterprise, Tourism and the Environment PO Box 5560, Civic Centre Victoria Avenue, Southend on Sea, SS2 6ZQ	Project Title Parking Review - Plan 8				Date	
	Drawing Title Colbert Avenue/Warwick Road Original and Proposed Amendments				Quality Project No. 08	
	Designed Drawn by Checked by Approved by				Scales not to scale	
Drawing Number CE 08 / /						
Drawing Status	Preliminary		Tender		Working	As Constructed

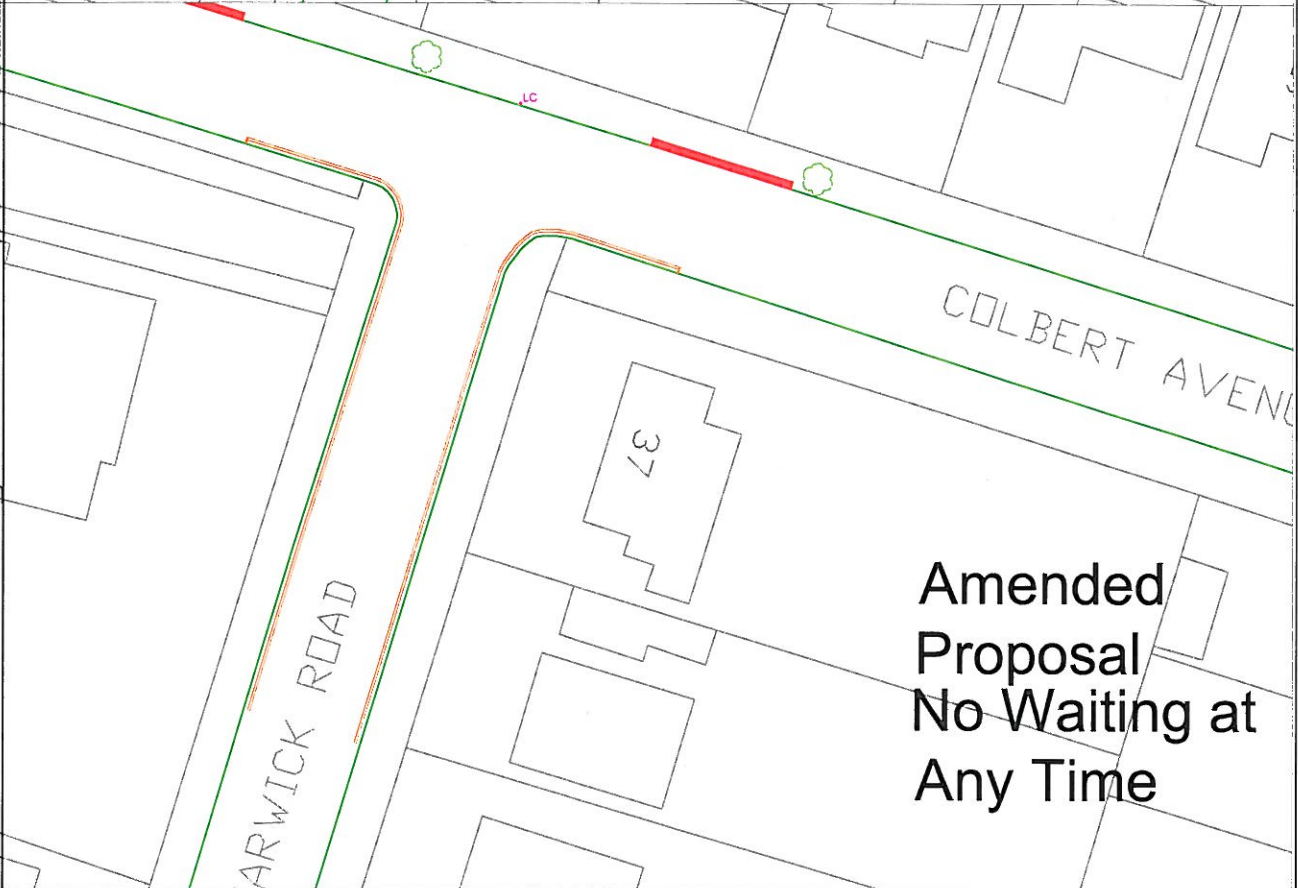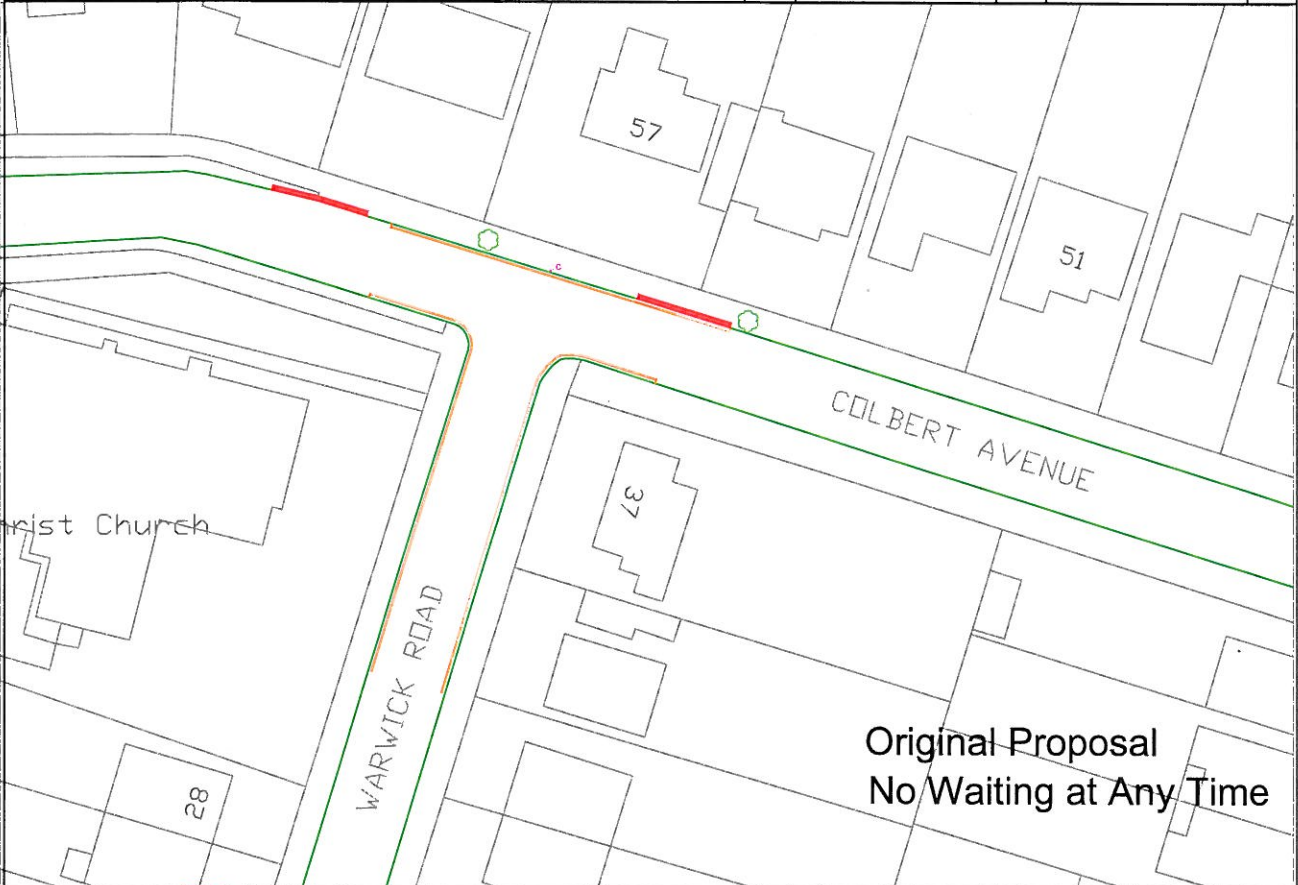

Southend on Sea Borough Council

Enterprise, Tourism
and the Environment
PO Box 5560, Civic Centre
Victoria Avenue, Southend on Sea,
SS2 6ZQ

Project Title
Parking Review - Plan 9

Drawing Title
**Byrne Drive
Proposed Amendments**

Date

Quality Project No.
09

Scales
not to scale

Designed Drawn by Checked by Approved by

Drawing Number
CE 09 / /


Drawing Status

Preliminary

Tender

Working

As Constructed

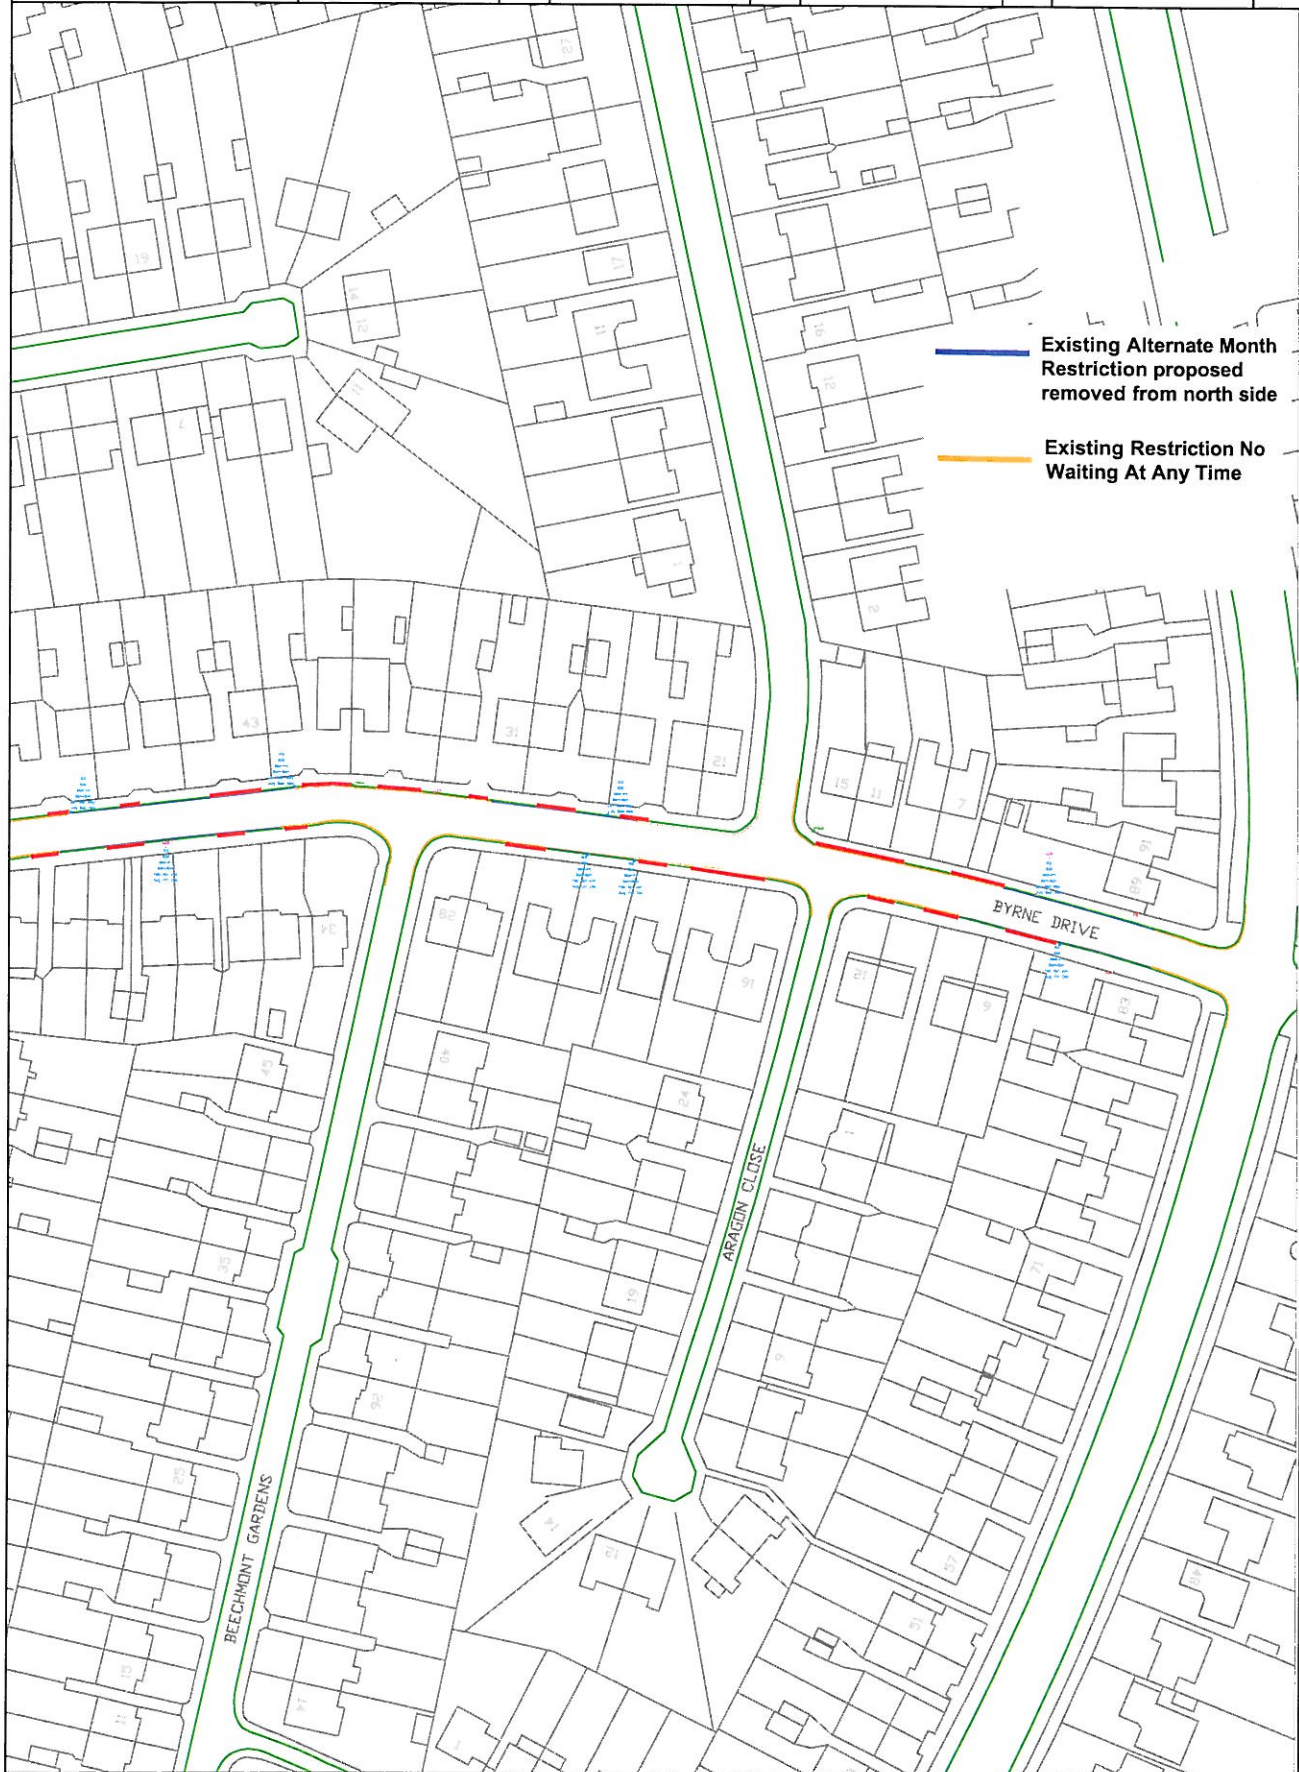

Southend on Sea Borough Council

Enterprise, Tourism
and the Environment
PO Box 5560, Civic Centre
Victoria Avenue, Southend on Sea,
SS2 6ZQ

Project Title
Parking Review - Plan 10

Drawing Title
**Hampton Gardens
Proposed Amendments**

Date

Quality Project No.

10

Scales
not to scale

Drawing Number

CE 10 / /

Designed

Drawn by

Checked by

Approved by


Drawing Status

Preliminary

Tender

Working

As Constructed

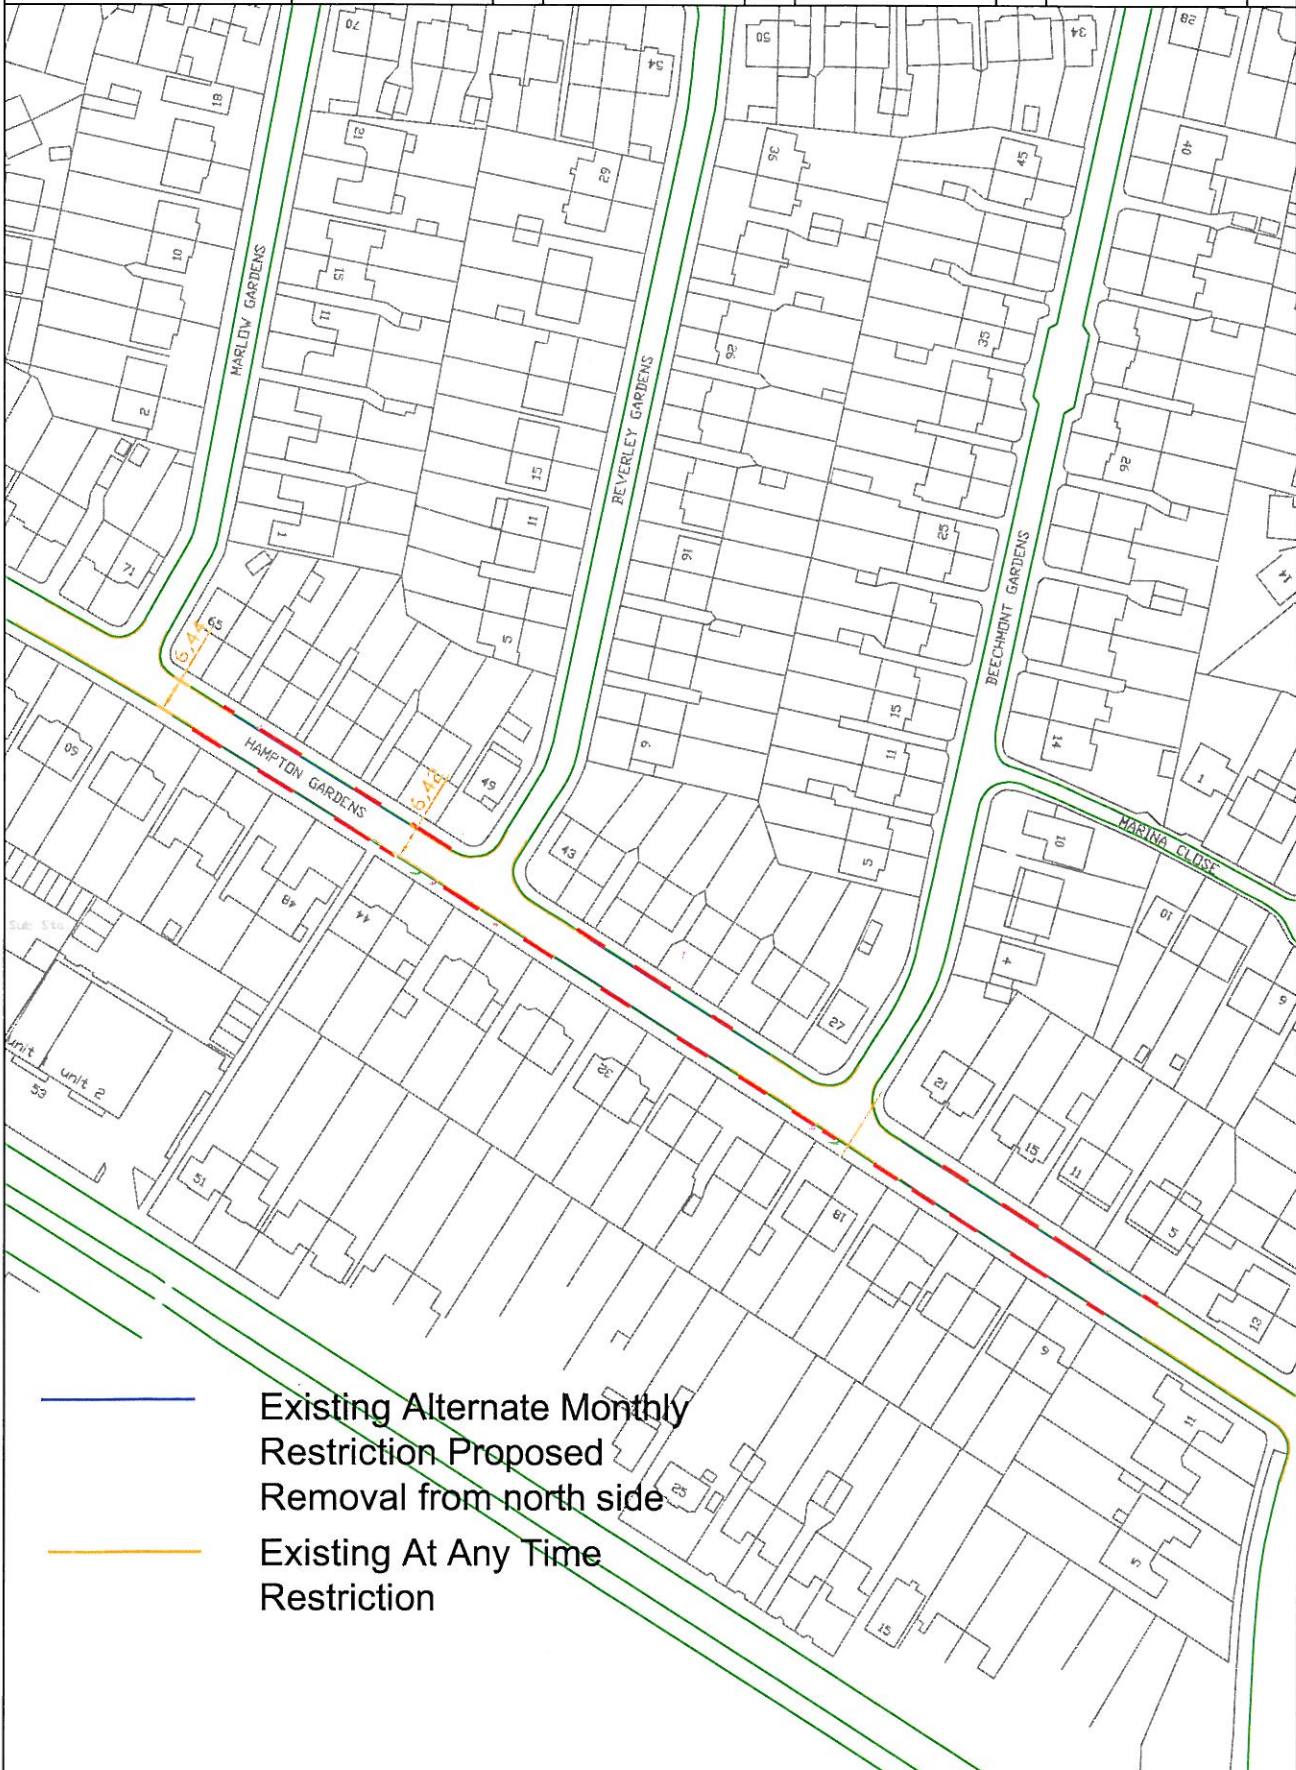

Southend on Sea Borough Council
 Enterprise, Tourism
 and the Environment
 PO Box 5560, Civic Centre
 Victoria Avenue, Southend on Sea,
 SS2 6ZQ

Project Title
Parking Review - Plan 11
Drawing Title
Thornford Gardens
Proposed Amendments

Date
Quality Project No.
 11
Scales
 not to scale
Drawing Number
 CE11 / /

Designed **Drawn by** **Checked by** **Approved by**


Drawing Status

Preliminary

Tender

Working

As Constructed

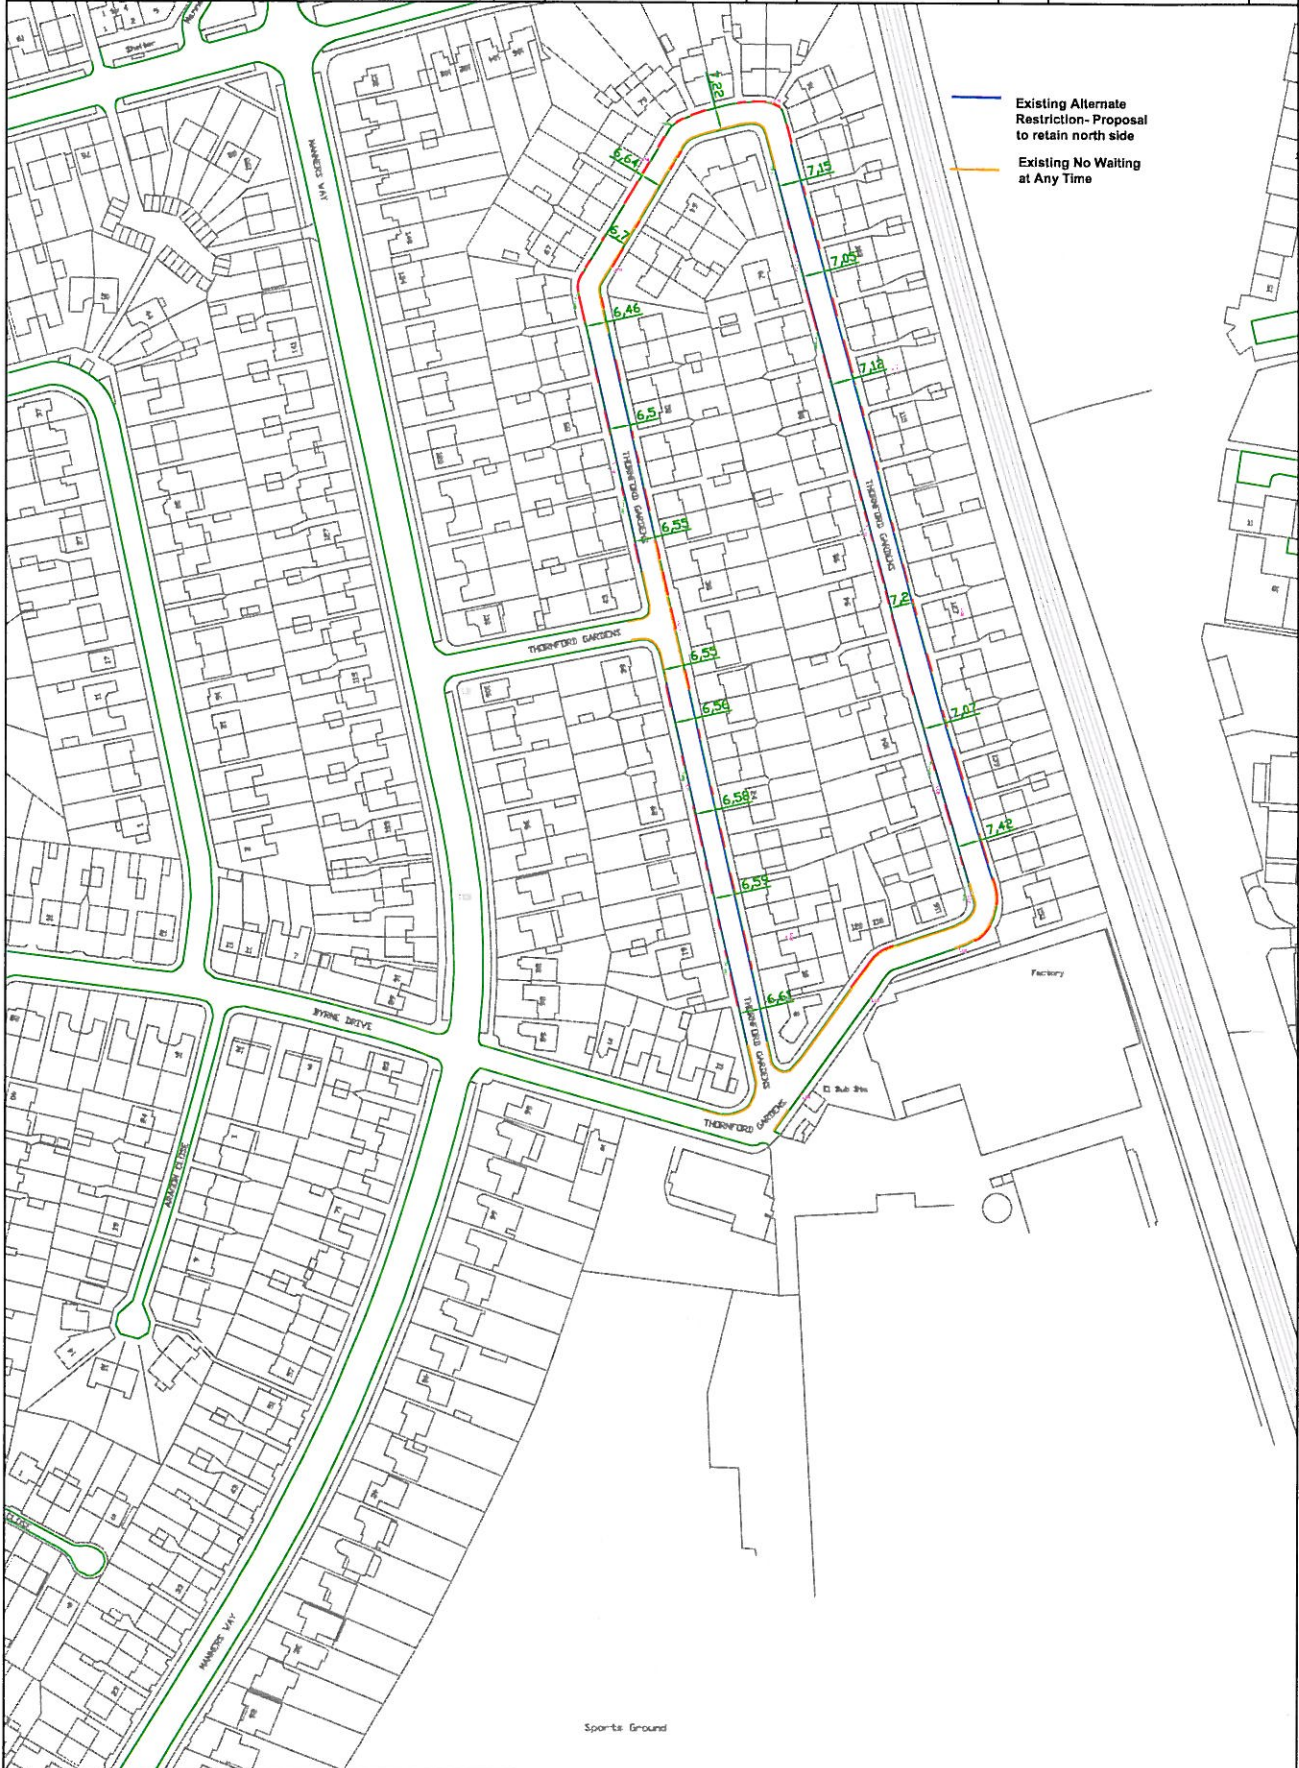

Southend on Sea Borough Council

Enterprise, Tourism
and the Environment
PO Box 5560, Civic Centre
Victoria Avenue, Southend on Sea,
SS2 6ZQ

Project Title
Parking Review - Plan 12

Drawing Title
**Keith Way
Proposed Amendments**

Date

Quality Project No.
12

Scales
not to scale

Designed Drawn by Checked by Approved by

Drawing Number
CE 12 / /


Drawing Status

Preliminary

Tender

Working

As Constructed

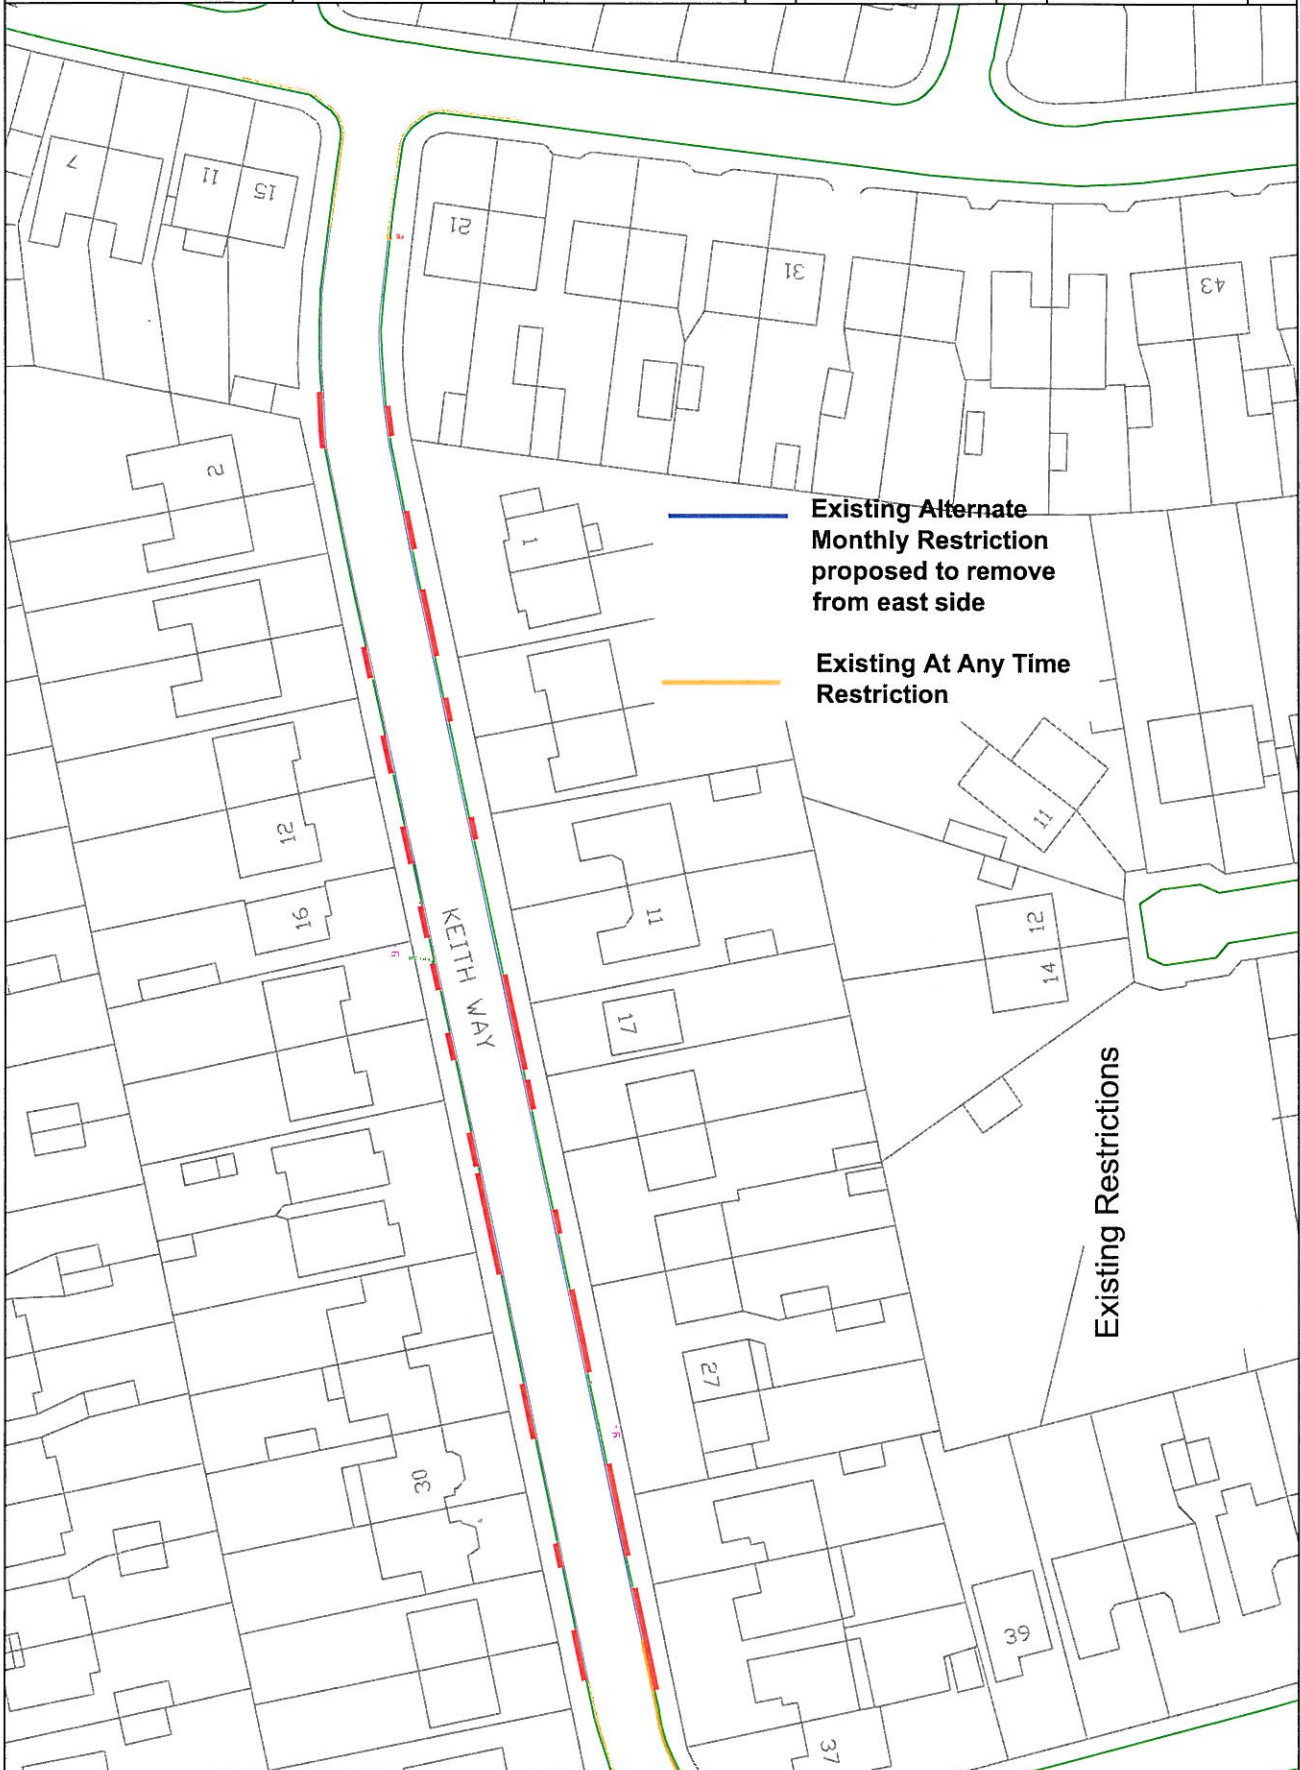

Southend on Sea Borough Council
 Enterprise, Tourism
 and the Environment
 PO Box 5560, Civic Centre
 Victoria Avenue, Southend on Sea,
 SS2 6ZQ

Project Title
Parking Review - Plan 13

Date

Drawing Title
**Christchurch Road/Wimborne Road
 Existing and Proposed Restrictions**


Quality Project No.
 13

Scales
 not to scale

Designed Drawn by Checked by Approved by

Drawing Number
 CE 13 / /

Drawing Status	Preliminary	Tender	Working	As Constructed
----------------	-------------	--------	---------	----------------

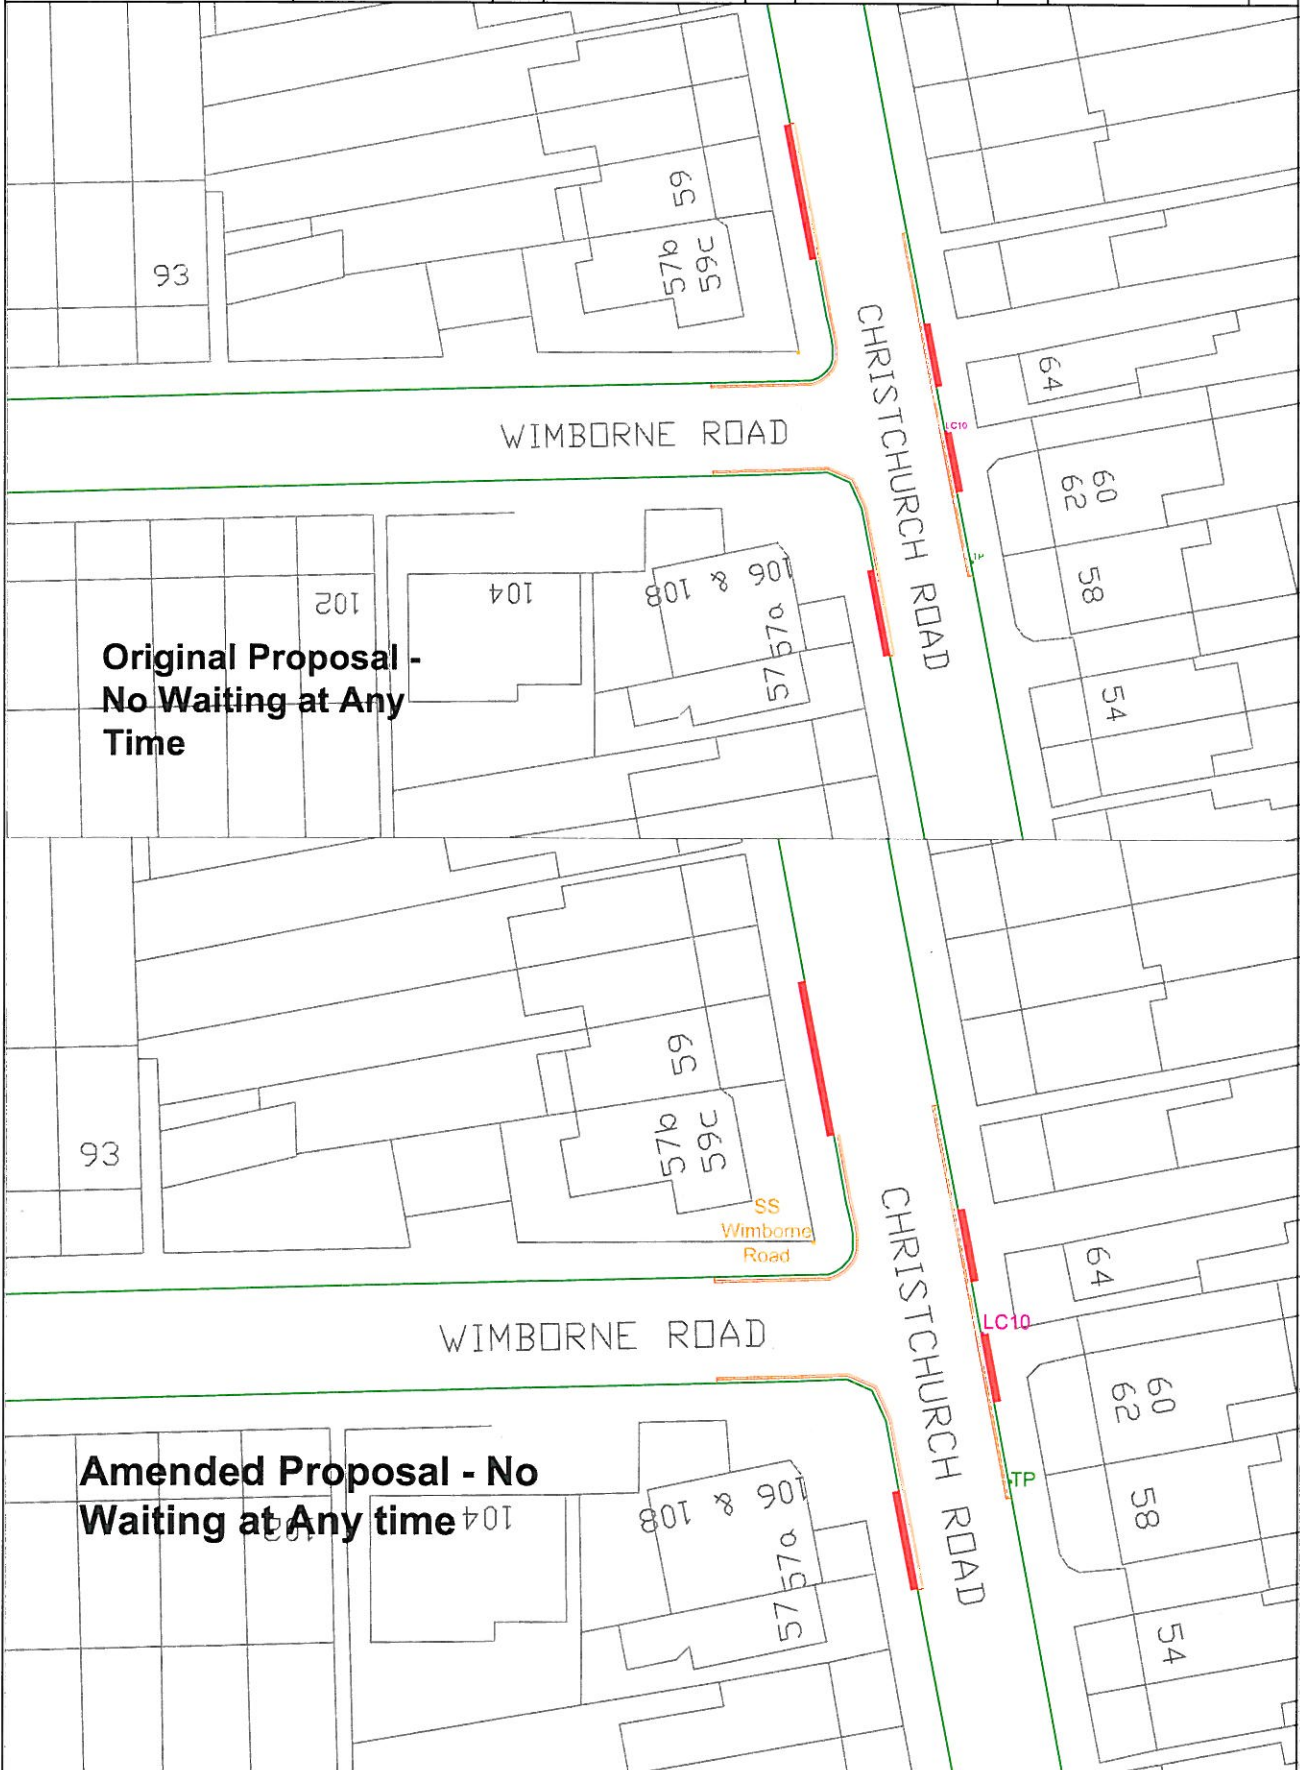

Southend on Sea Borough Council
 Enterprise, Tourism
 and the Environment
 PO Box 5560, Civic Centre
 Victoria Avenue, Southend on Sea,
 SS2 6ZQ

Project Title
Parking Review - Plan 14

Date

Drawing Title
Christchurch Road/Boscombe Road
Original Proposal

Quality Project No.
 14
 Scales
 not to scale

Designed Drawn by Checked by Approved by

Drawing Number
 CE 14 / /

Drawing Status

Preliminary

Tender

Working

As Constructed



**Original Proposal -
 No Waiting at Any
 Time**


Southend on Sea Borough Council
 Enterprise, Tourism
 and the Environment
 PO Box 5560, Civic Centre
 Victoria Avenue, Southend on Sea,
 SS2 6ZQ

Project Title
Parking Review - Plan 15
 Drawing Title
Christchurch Road junction Branksome Road
Original and Amended Proposals

Date
 Quality Project No.
 15
 Scales
 not to scale
 Drawing Number
 CE 15 / /

Designed
 Drawn by
 Checked by
 Approved by

Drawing Status	Preliminary	Tender	Working	As Constructed
----------------	-------------	--------	---------	----------------

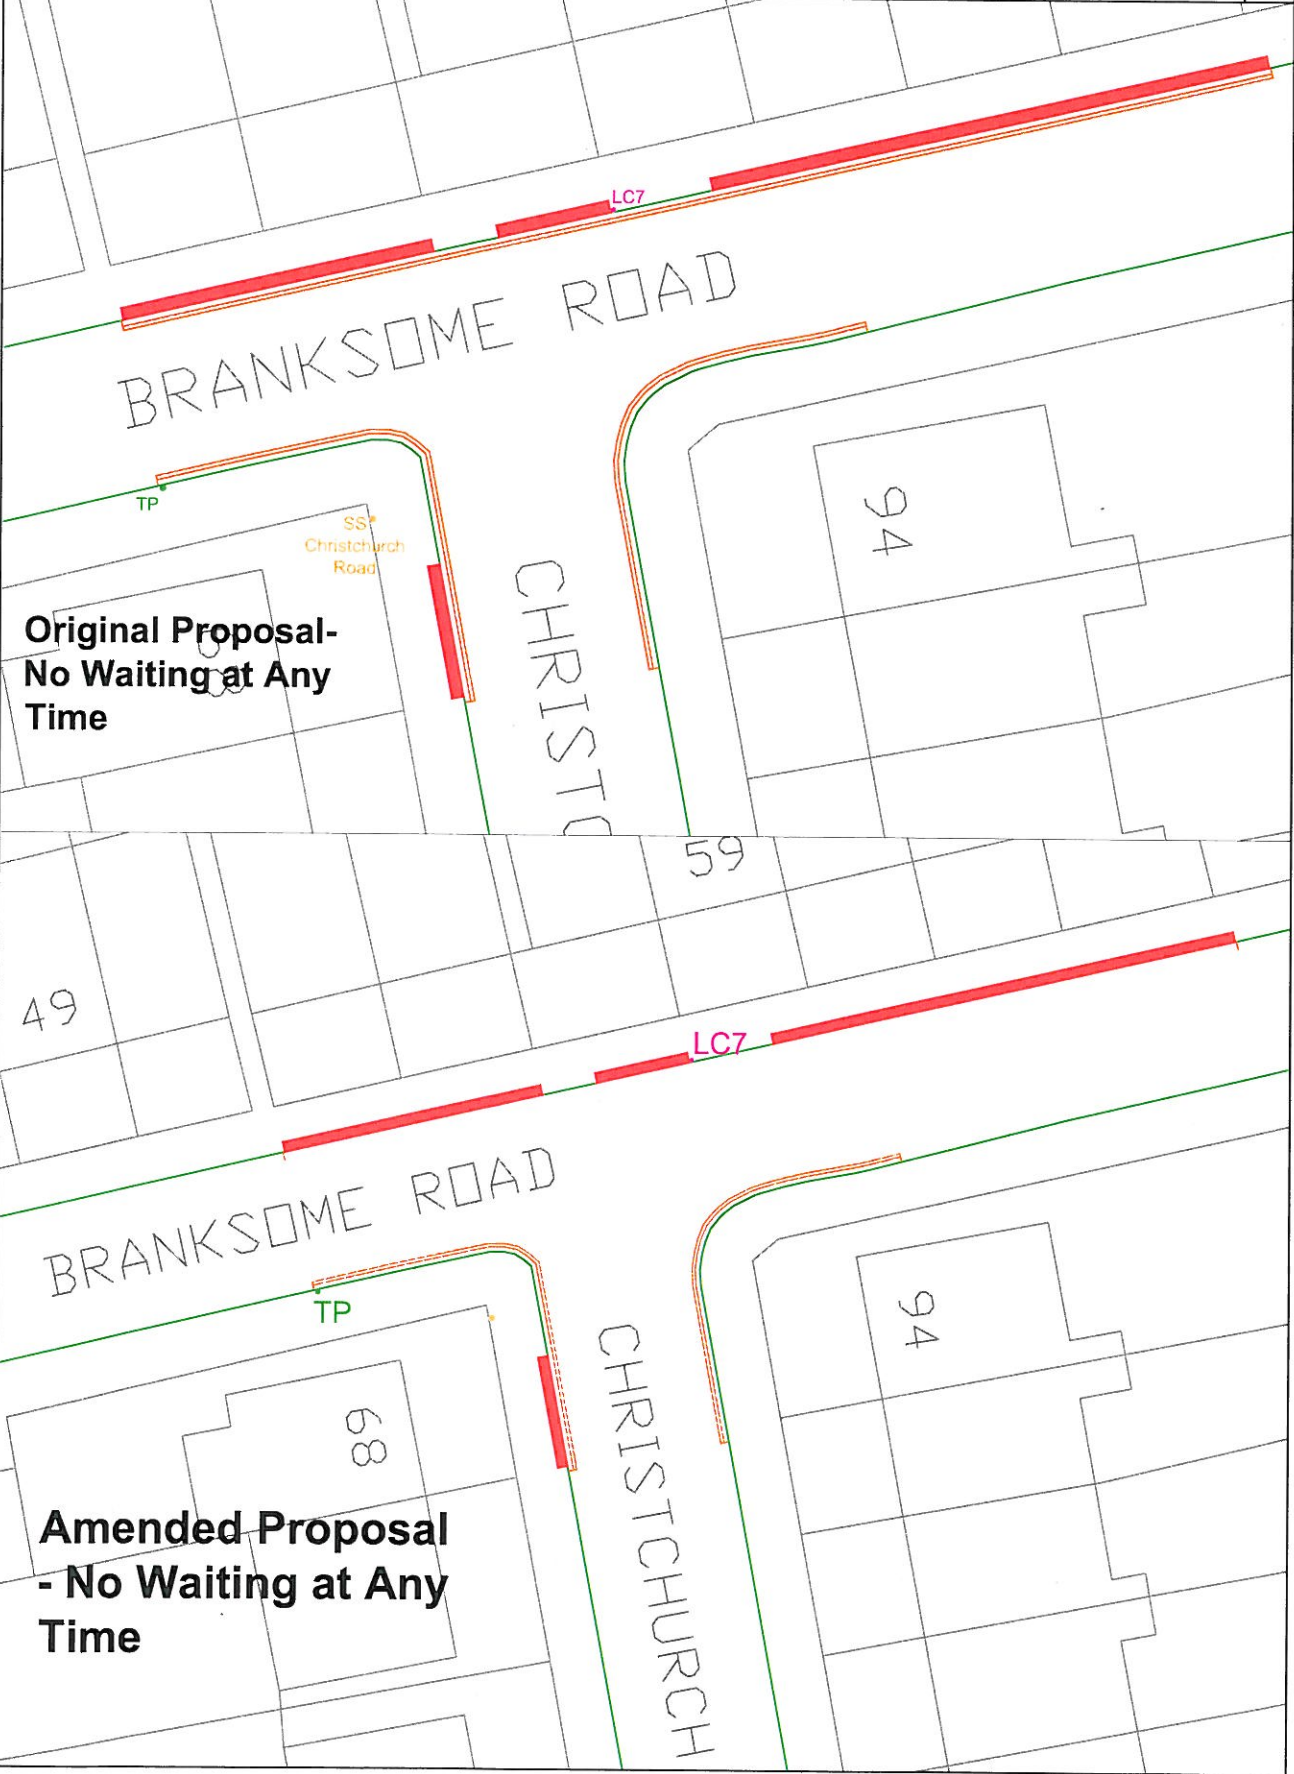


Original Proposal - No Waiting at Any Time

Amended Proposal - No Waiting at Any Time

Southend on Sea Borough Council Enterprise, Tourism and the Environment PO Box 5560, Civic Centre Victoria Avenue, Southend on Sea, SS2 6ZQ	Project Title Parking Review - Plan 16			Date
	Drawing Title Branksome/Oban/Trinity			Quality Project No. 16
	Original Proposal			Scales not to scale
Designed	Drawn by	Checked by	Approved by	Drawing Number CE 16 / /

Drawing Status	Preliminary	Tender	Working	As Constructed
----------------	-------------	--------	---------	----------------

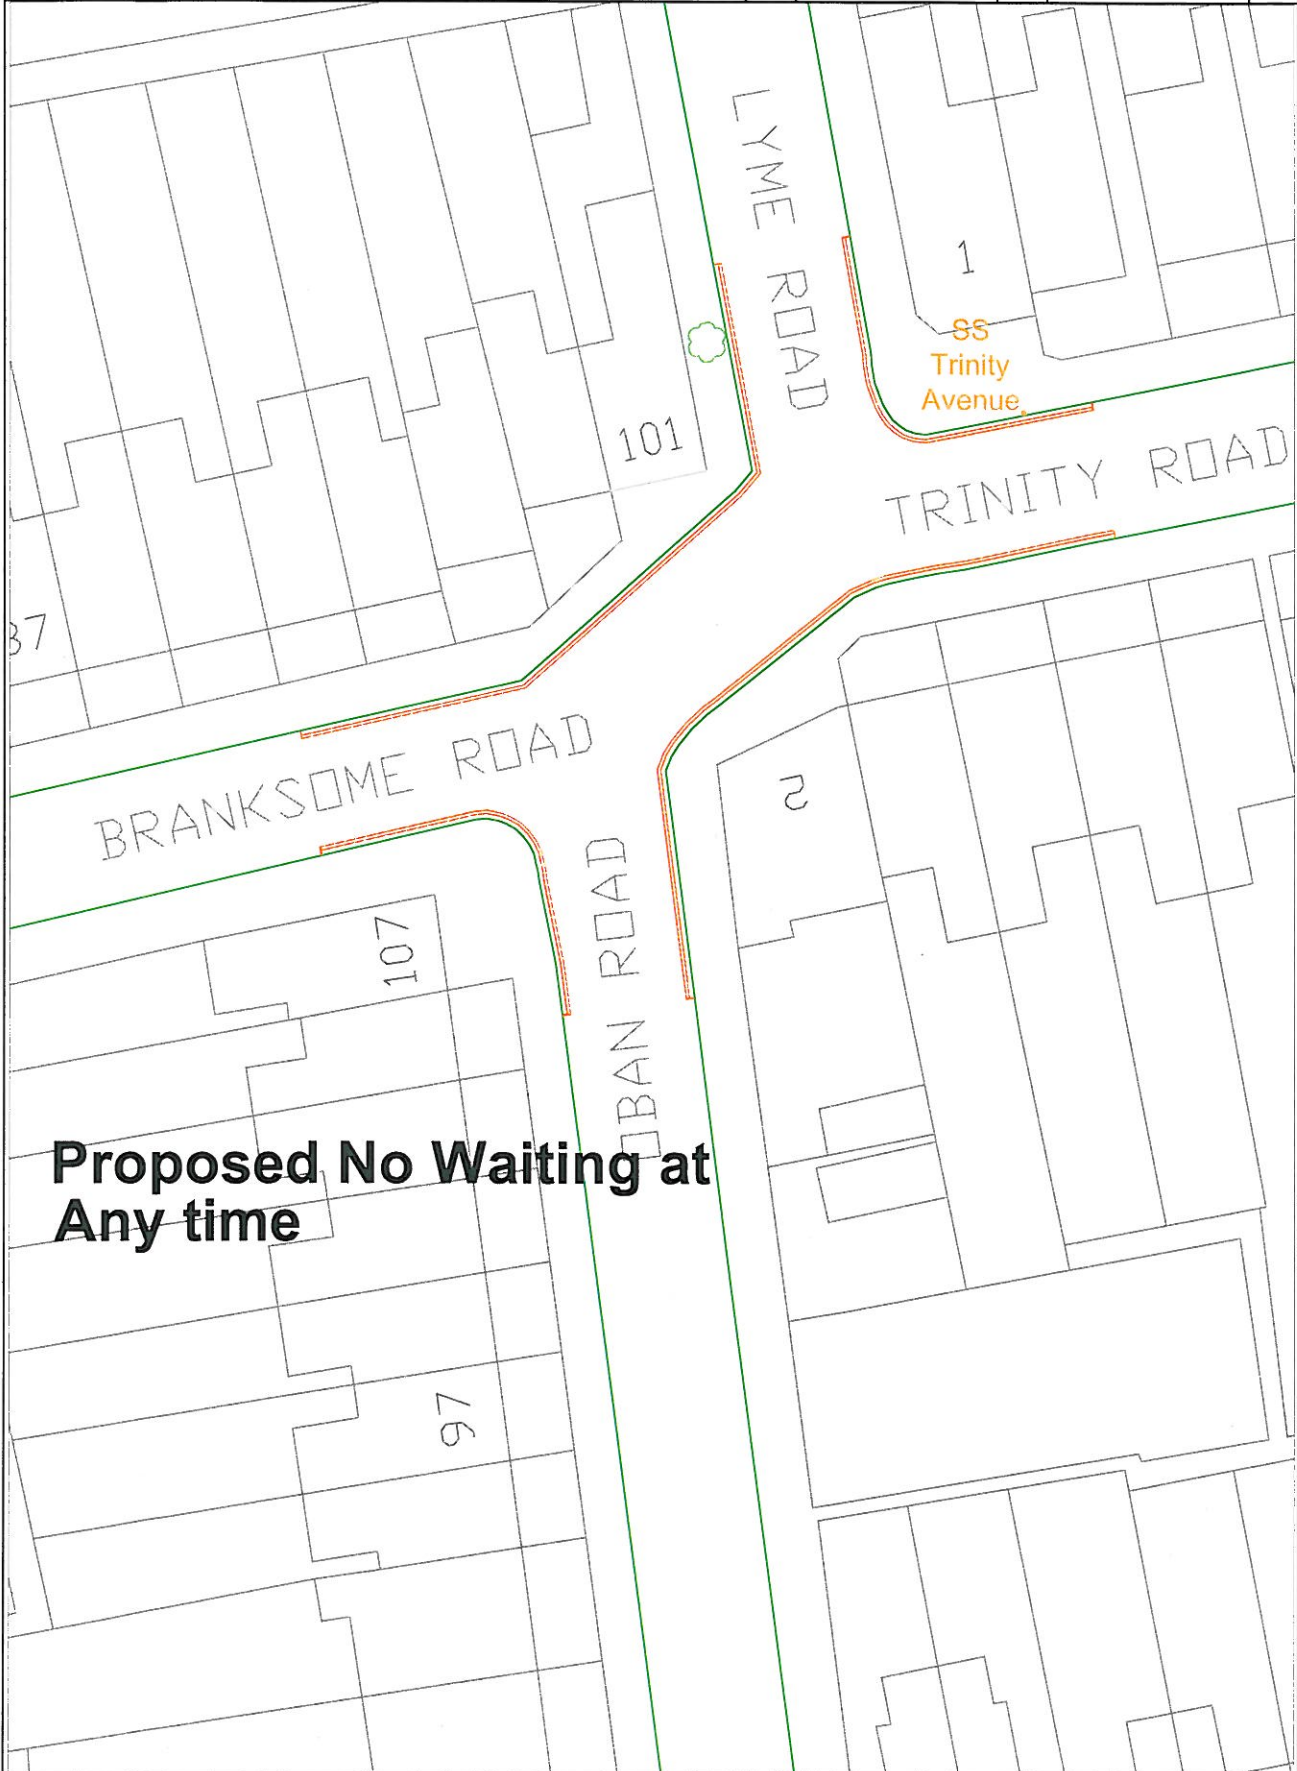

Southend on Sea Borough Council
 Enterprise, Tourism
 and the Environment
 PO Box 5560, Civic Centre
 Victoria Avenue, Southend on Sea,
 SS2 6ZQ


Project Title
Parking Review - Plan 17

Drawing Title
**Rochford Road
 Proposed Extent of Restrictions**

Date
 Quality Project No.
 17
 Scales
 not to scale
 Drawing Number
 CE 17 / /

Designed _____ Drawn by _____ Checked by _____ Approved by _____

Drawing Status	Preliminary	Tender	Working	As Constructed
----------------	-------------	--------	---------	----------------

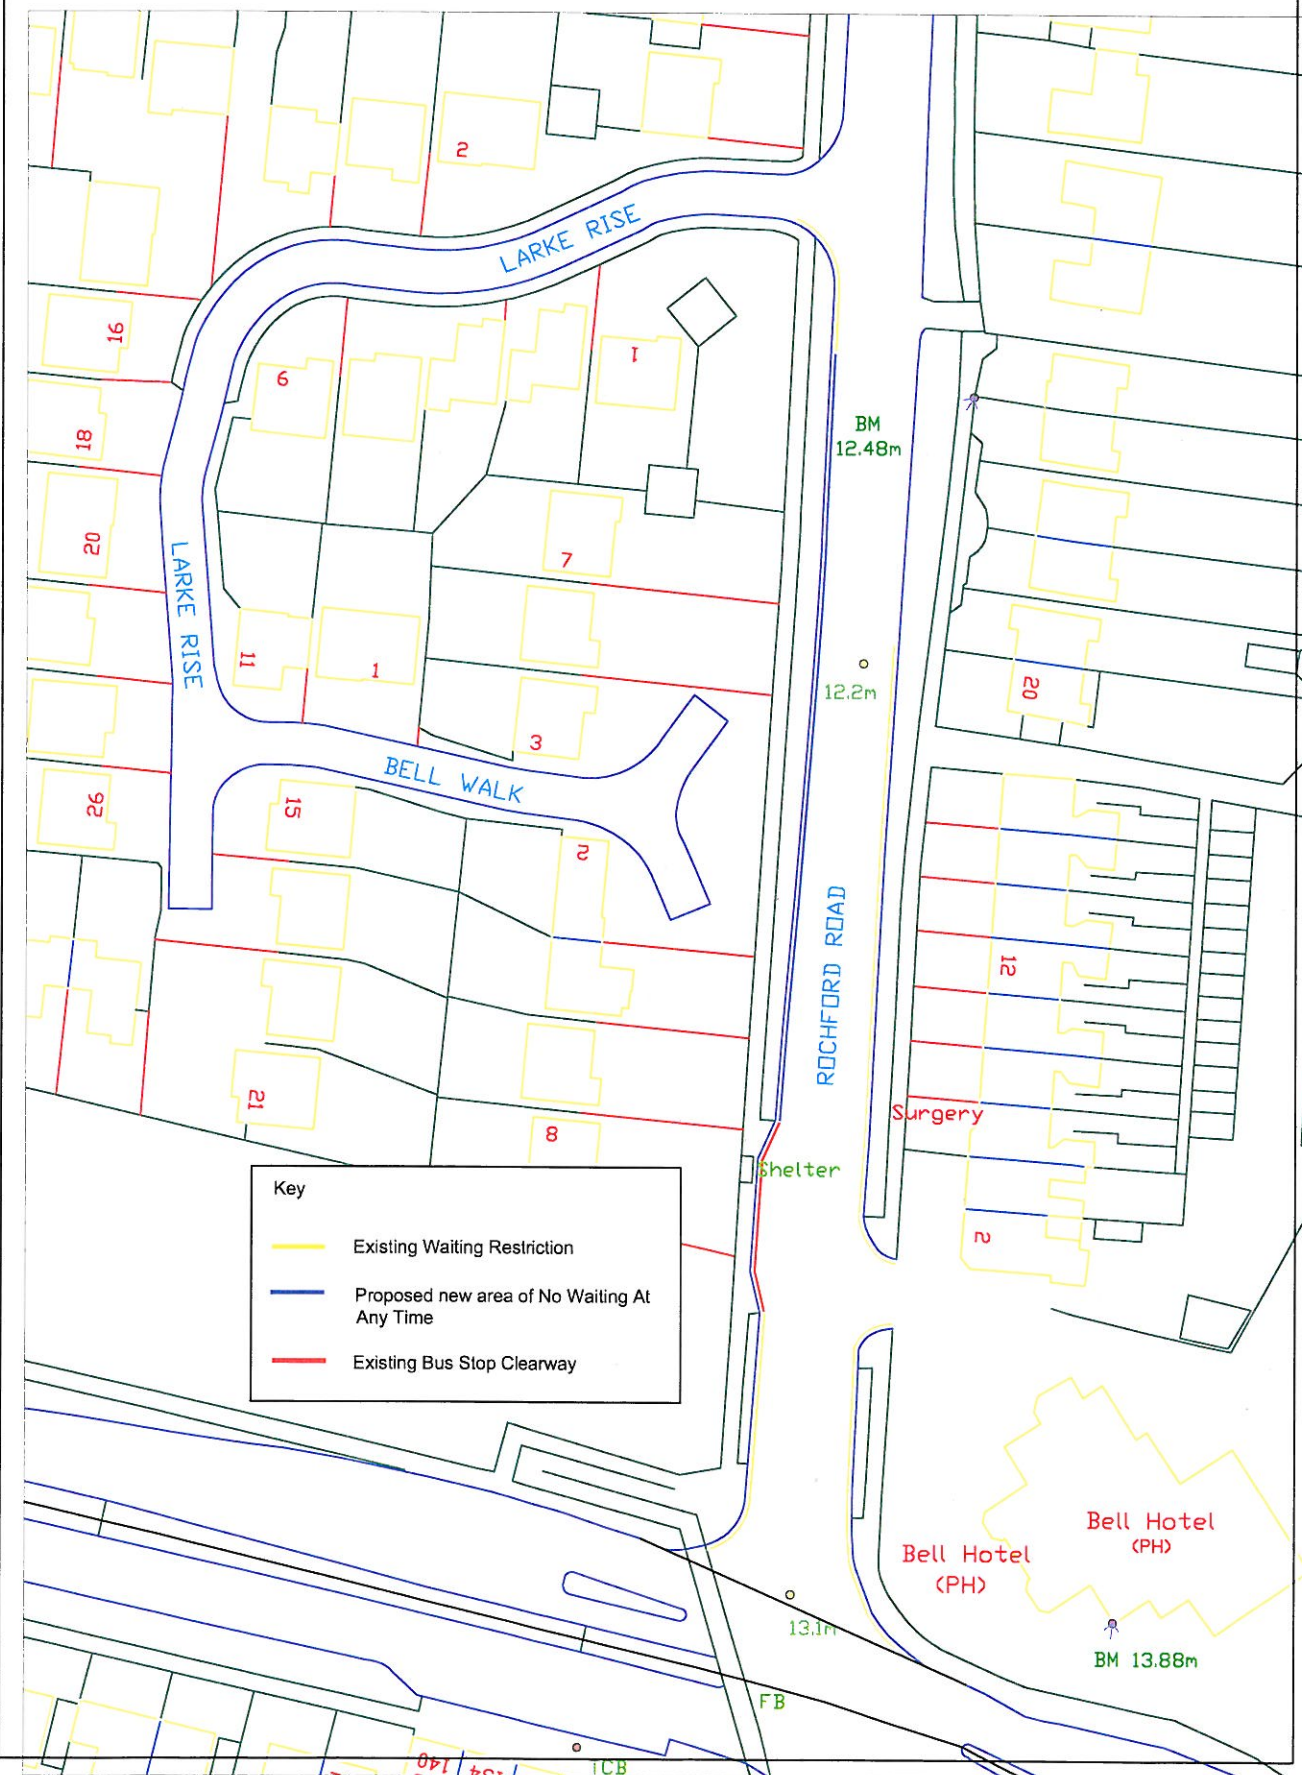


Southend on Sea Borough Council
 Enterprise, Tourism
 and the Environment
 PO Box 5560, Civic Centre
 Victoria Avenue, Southend on Sea,
 SS2 6ZQ

Project Title
Parking Review - Plan 18
 Drawing Title
**Four Sisters Way
 Proposed Restrictions**

Date
 Quality Project No.
 18
 Scales
 not to scale
 Drawing Number
 CE 18 / /

Designed _____ Drawn by _____ Checked by _____ Approved by _____

Drawing Status	Preliminary	Tender	Working	As Constructed
----------------	-------------	--------	---------	----------------

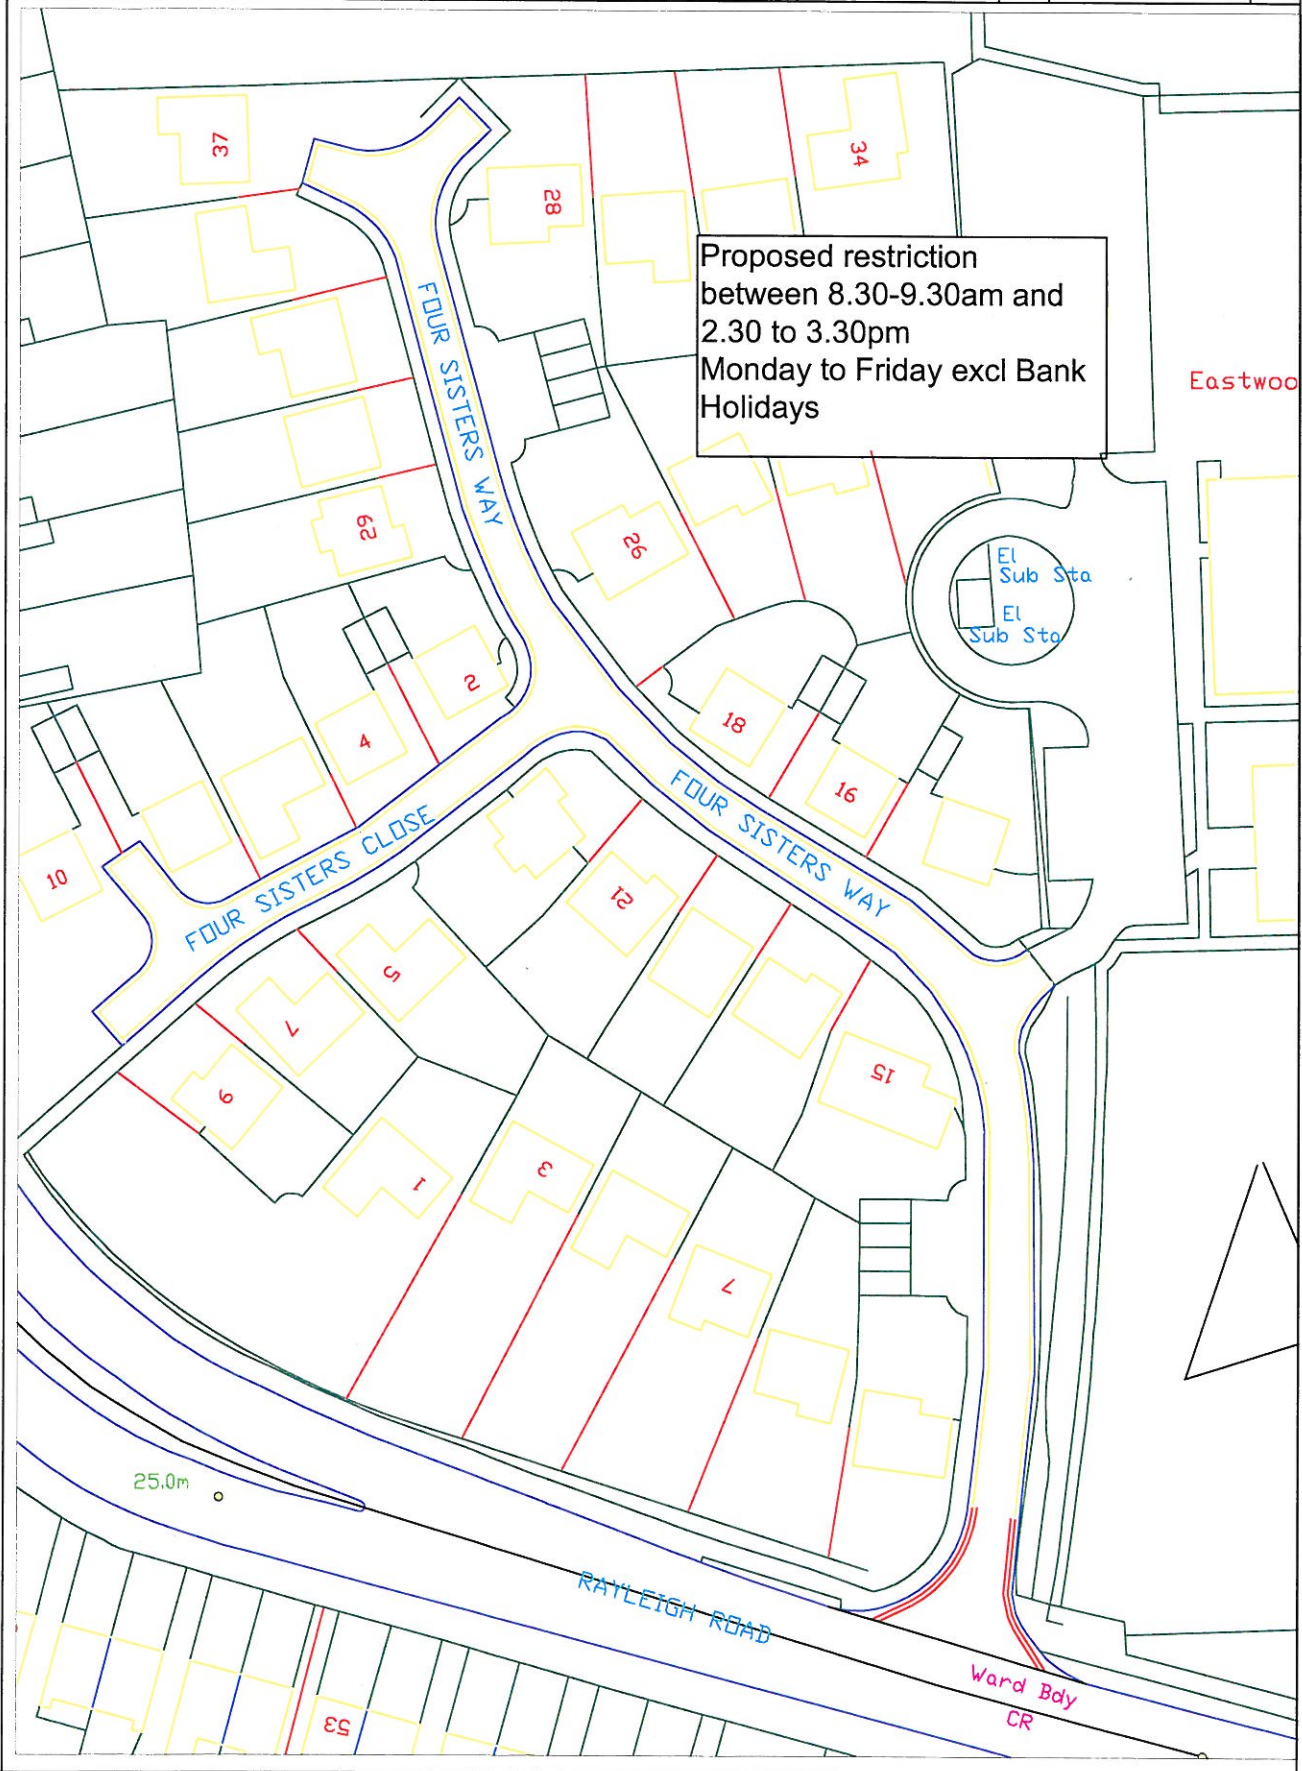

Southend on Sea Borough Council Enterprise, Tourism and the Environment PO Box 5560, Civic Centre Victoria Avenue, Southend on Sea, SS2 6ZQ	Project Title Parking Review - Plan 19			Date
	Drawing Title Oak Walk Original Proposal			Quality Project No. 19
	Designed	Drawn by	Checked by	Approved by
				Drawing Number CE 19 / /

Drawing Status	Preliminary		Tender		Working		As Constructed
----------------	-------------	--	--------	--	---------	--	----------------



Southend on Sea Borough Council
 Enterprise, Tourism
 and the Environment
 PO Box 5560, Civic Centre
 Victoria Avenue, Southend on Sea,
 SS2 6ZQ

Project Title
Parking Review - Plan 20

Date

Drawing Title
**Quebec Avenue/Toledo Road/Hillcrest Road
 Original and Amended Proposal**

Quality Project No.

20
 Scales
 not to scale

Designed

Drawn by

Checked by

Approved by

Drawing Number

CE 20 / /


Drawing Status

Preliminary

Tender

Working

As Constructed

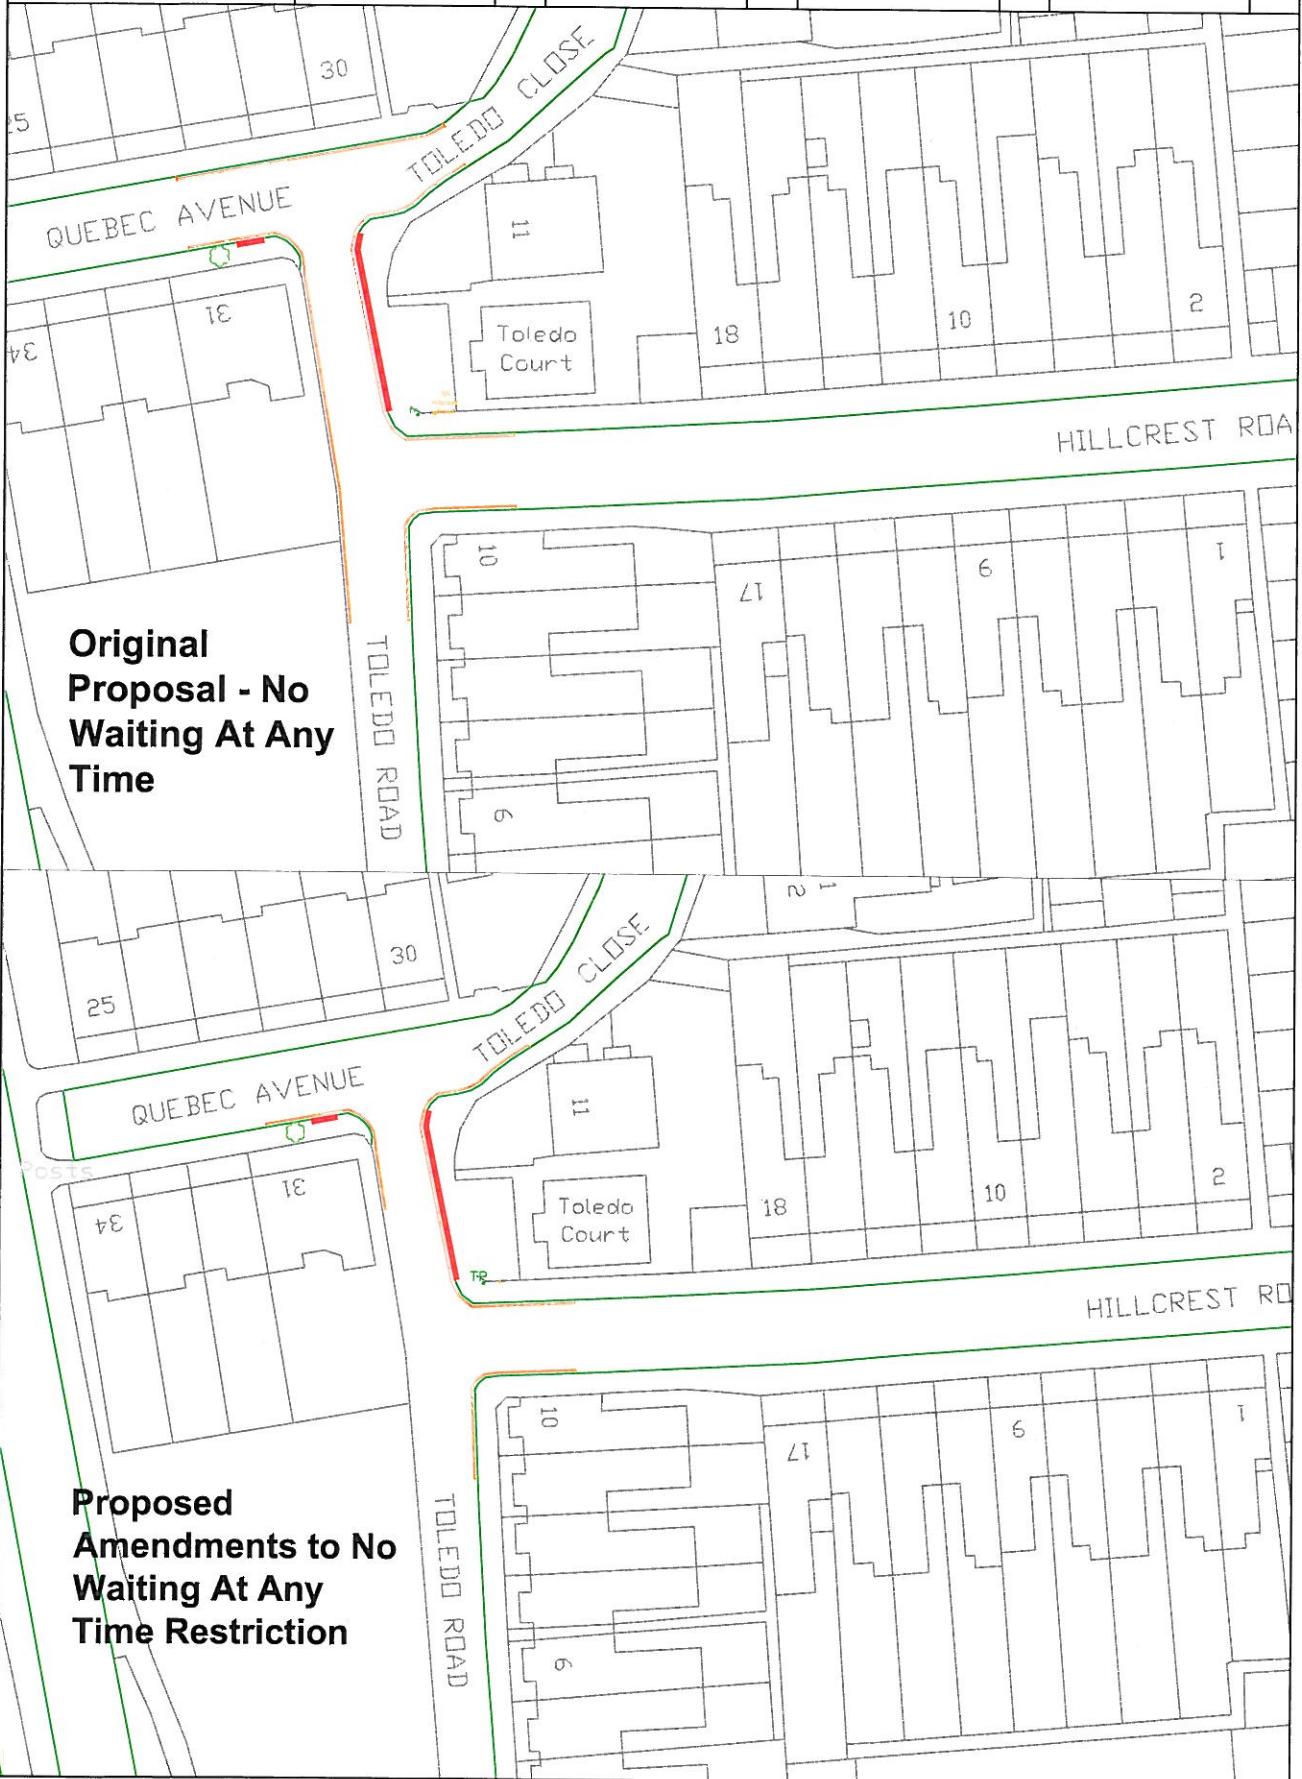

**Original
 Proposal - No
 Waiting At Any
 Time**

**Proposed
 Amendments to No
 Waiting At Any
 Time Restriction**