

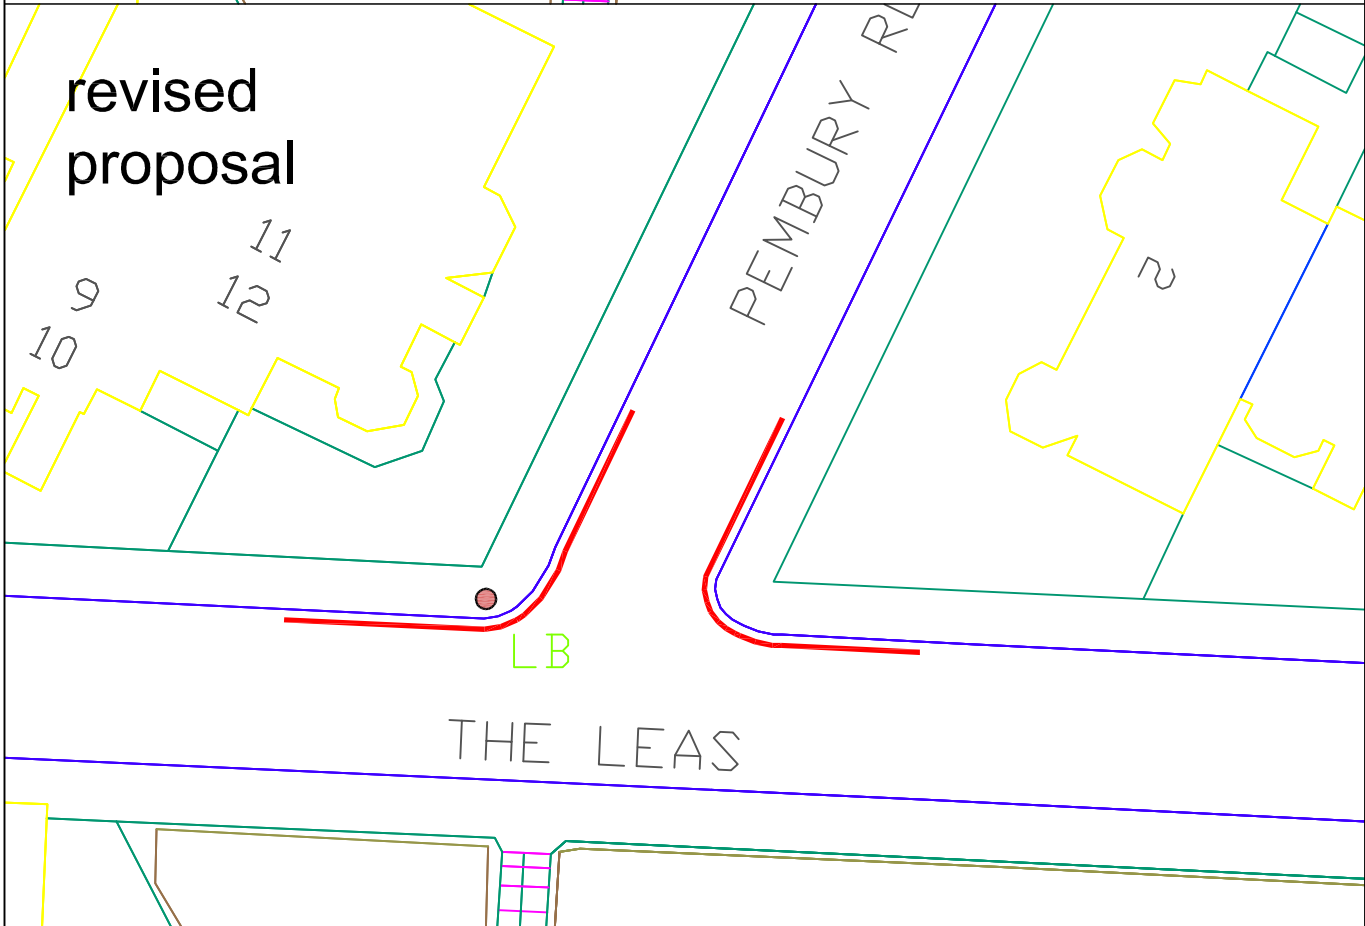




Southend on Sea Borough Council Enterprise, Tourism and the Environment PO Box 5560, Civic Centre Victoria Avenue, Southend on Sea, SS2 6ZQ		Project Title				Date
		Drawing Title				Quality Project No.
		The Leas/Pembury Road Plan 1				00000/00 Scales not to scale
Designed	Drawn by	Checked by	Approved by	Drawing Number		
CHT				CE 9999/ /		
Drawing Status	Preliminary		Tender		Working	As Constructed

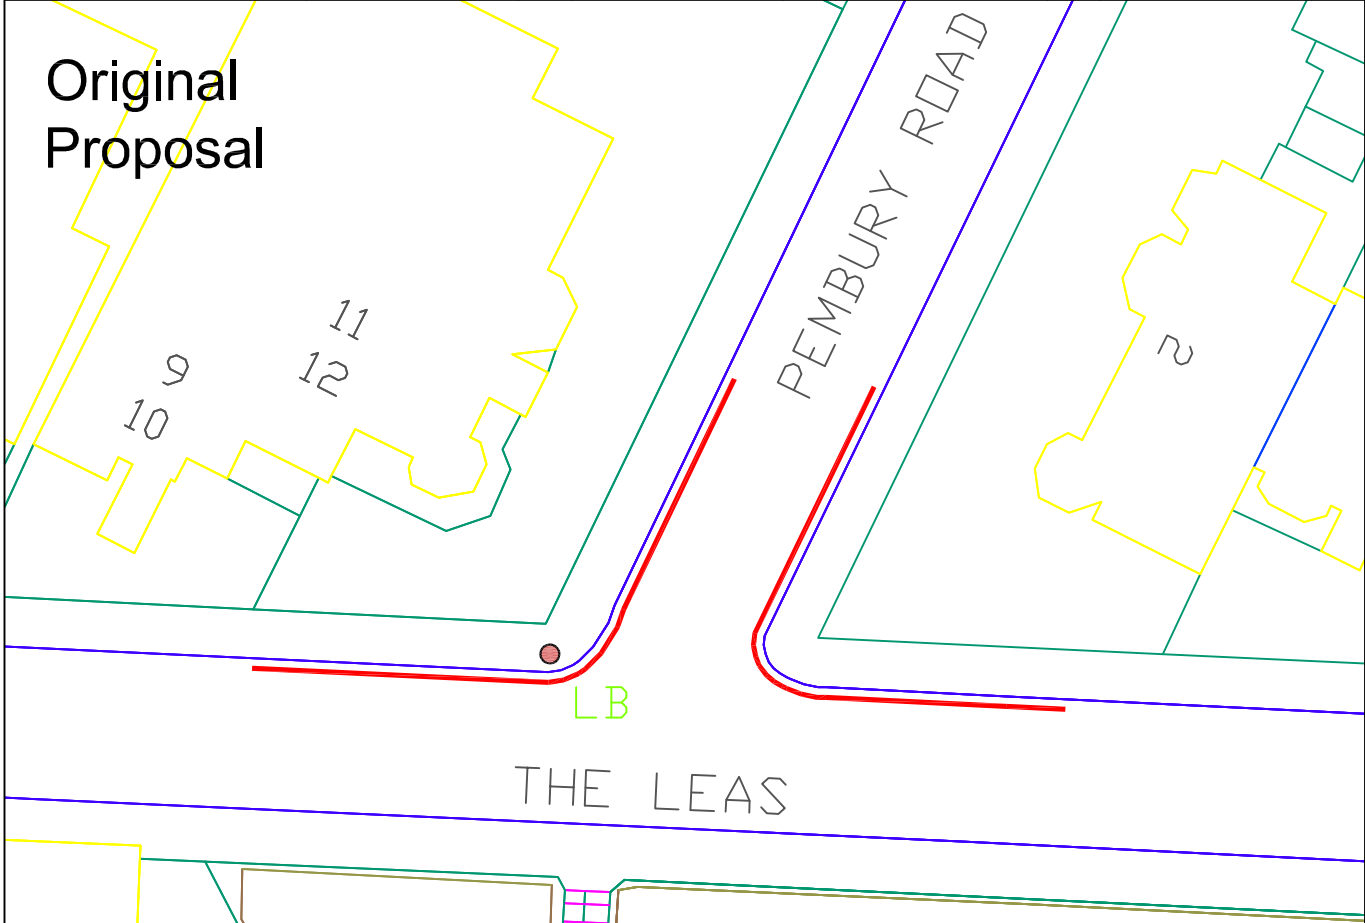

Southend on Sea Borough Council Enterprise, Tourism and the Environment PO Box 5560, Civic Centre Victoria Avenue, Southend on Sea, SS2 6ZQ		Project Title Junction Reviews			Date Nov 08	
		Drawing Title The Leas/Cobham Road Plan 3			Quality Project No. 00000/00	
		Designed CHT	Drawn by the Leas/Cobham Road	Checked by	Approved by	Scales not to scale
Drawing Status		Preliminary	Tender	Working	As Constructed	Drawing Number CE 9999/ /

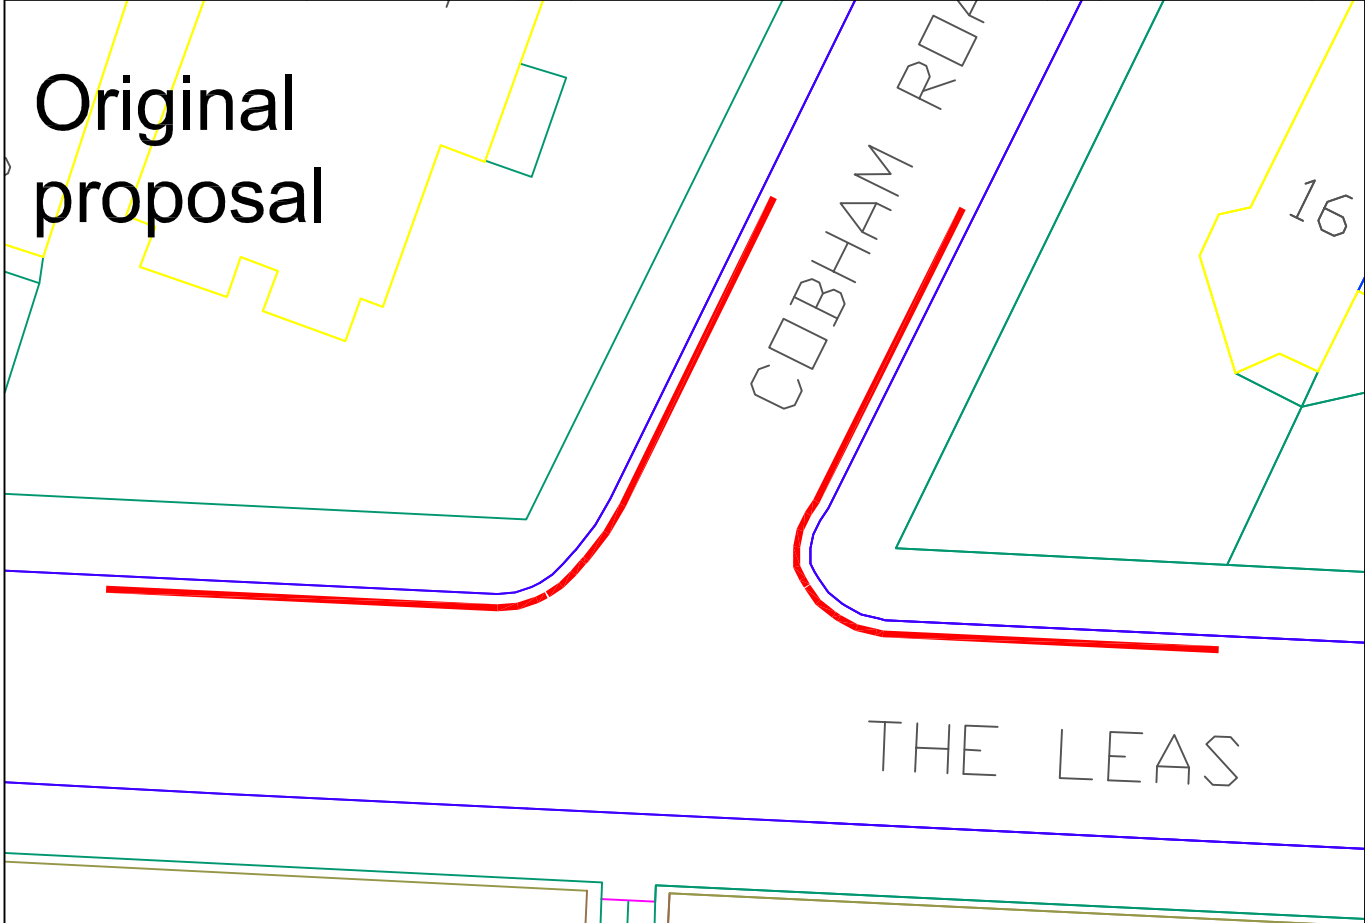

Southend on Sea Borough Council Enterprise, Tourism and the Environment PO Box 5560, Civic Centre Victoria Avenue, Southend on Sea, SS2 6ZQ		Project Title Junction Reviews Drawing Title The Leas/Palmerston Plan 2			Date Nov 08	
		Designed CHT			Drawn by	Checked by
Drawing Status		Preliminary	Tender	Working		As Constructed
					Quality Project No. 00000/00	
					Scales not to scale	
					Drawing Number CE 9999/ /	

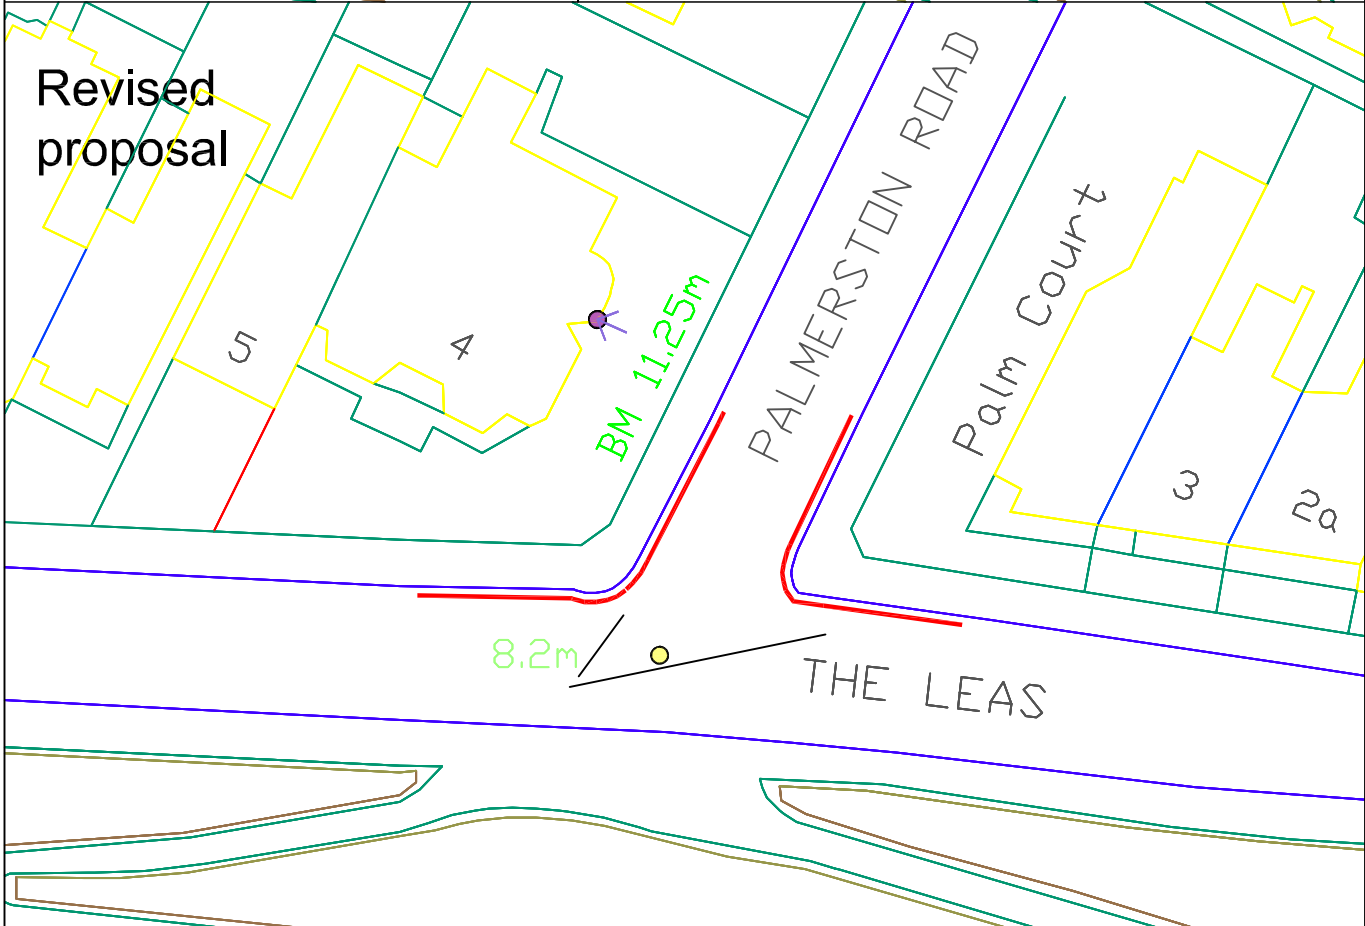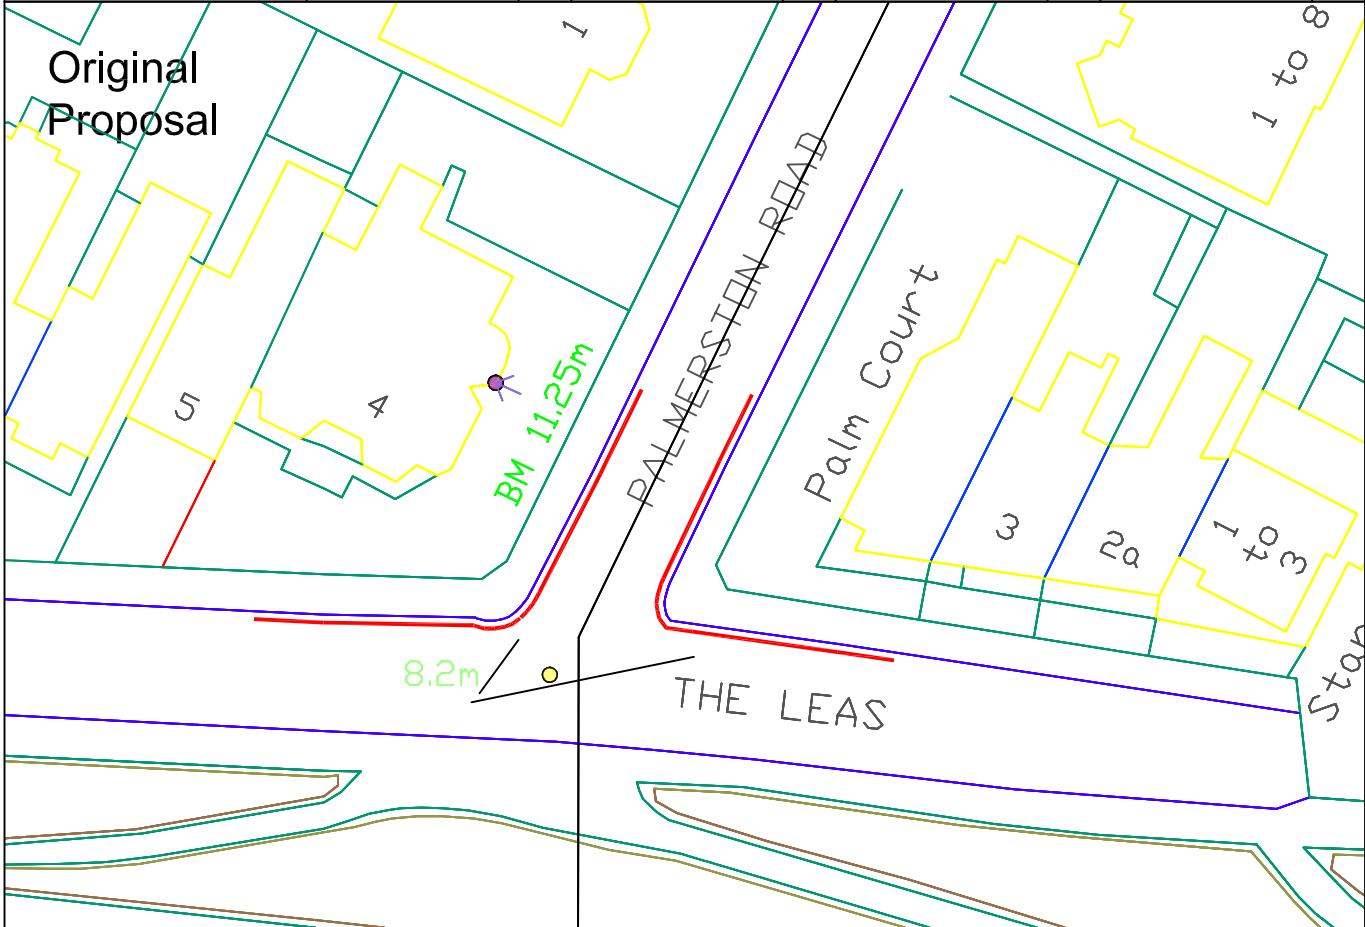

Southend on Sea Borough Council Enterprise, Tourism and the Environment PO Box 5560, Civic Centre Victoria Avenue, Southend on Sea, SS2 6ZQ		Project Title Parking Reviews			Date Nov 08	
		Drawing Title Seaforth Road Plan 7			Quality Project No. 00000/00	
		Designed CHT	Drawn by	Checked by	Approved by	Scales not to scale
Drawing Status Preliminary		Tender		Working		Drawing Number CE 9999/ /



Southend on Sea Borough Council

Enterprise, Tourism
and the Environment
PO Box 5560, Civic Centre
Victoria Avenue, Southend on Sea,
SS2 6ZQ

Project Title
Parking Review

Drawing Title
**Old Leigh Road
Plan 4**

Date

Quality Project No.
00000/00

Scales
not to scale

Designed

Drawn by

Checked by

Approved by

Drawing Number
CE 9999/ /


Drawing Status

Preliminary


Tender

Working

As Constructed

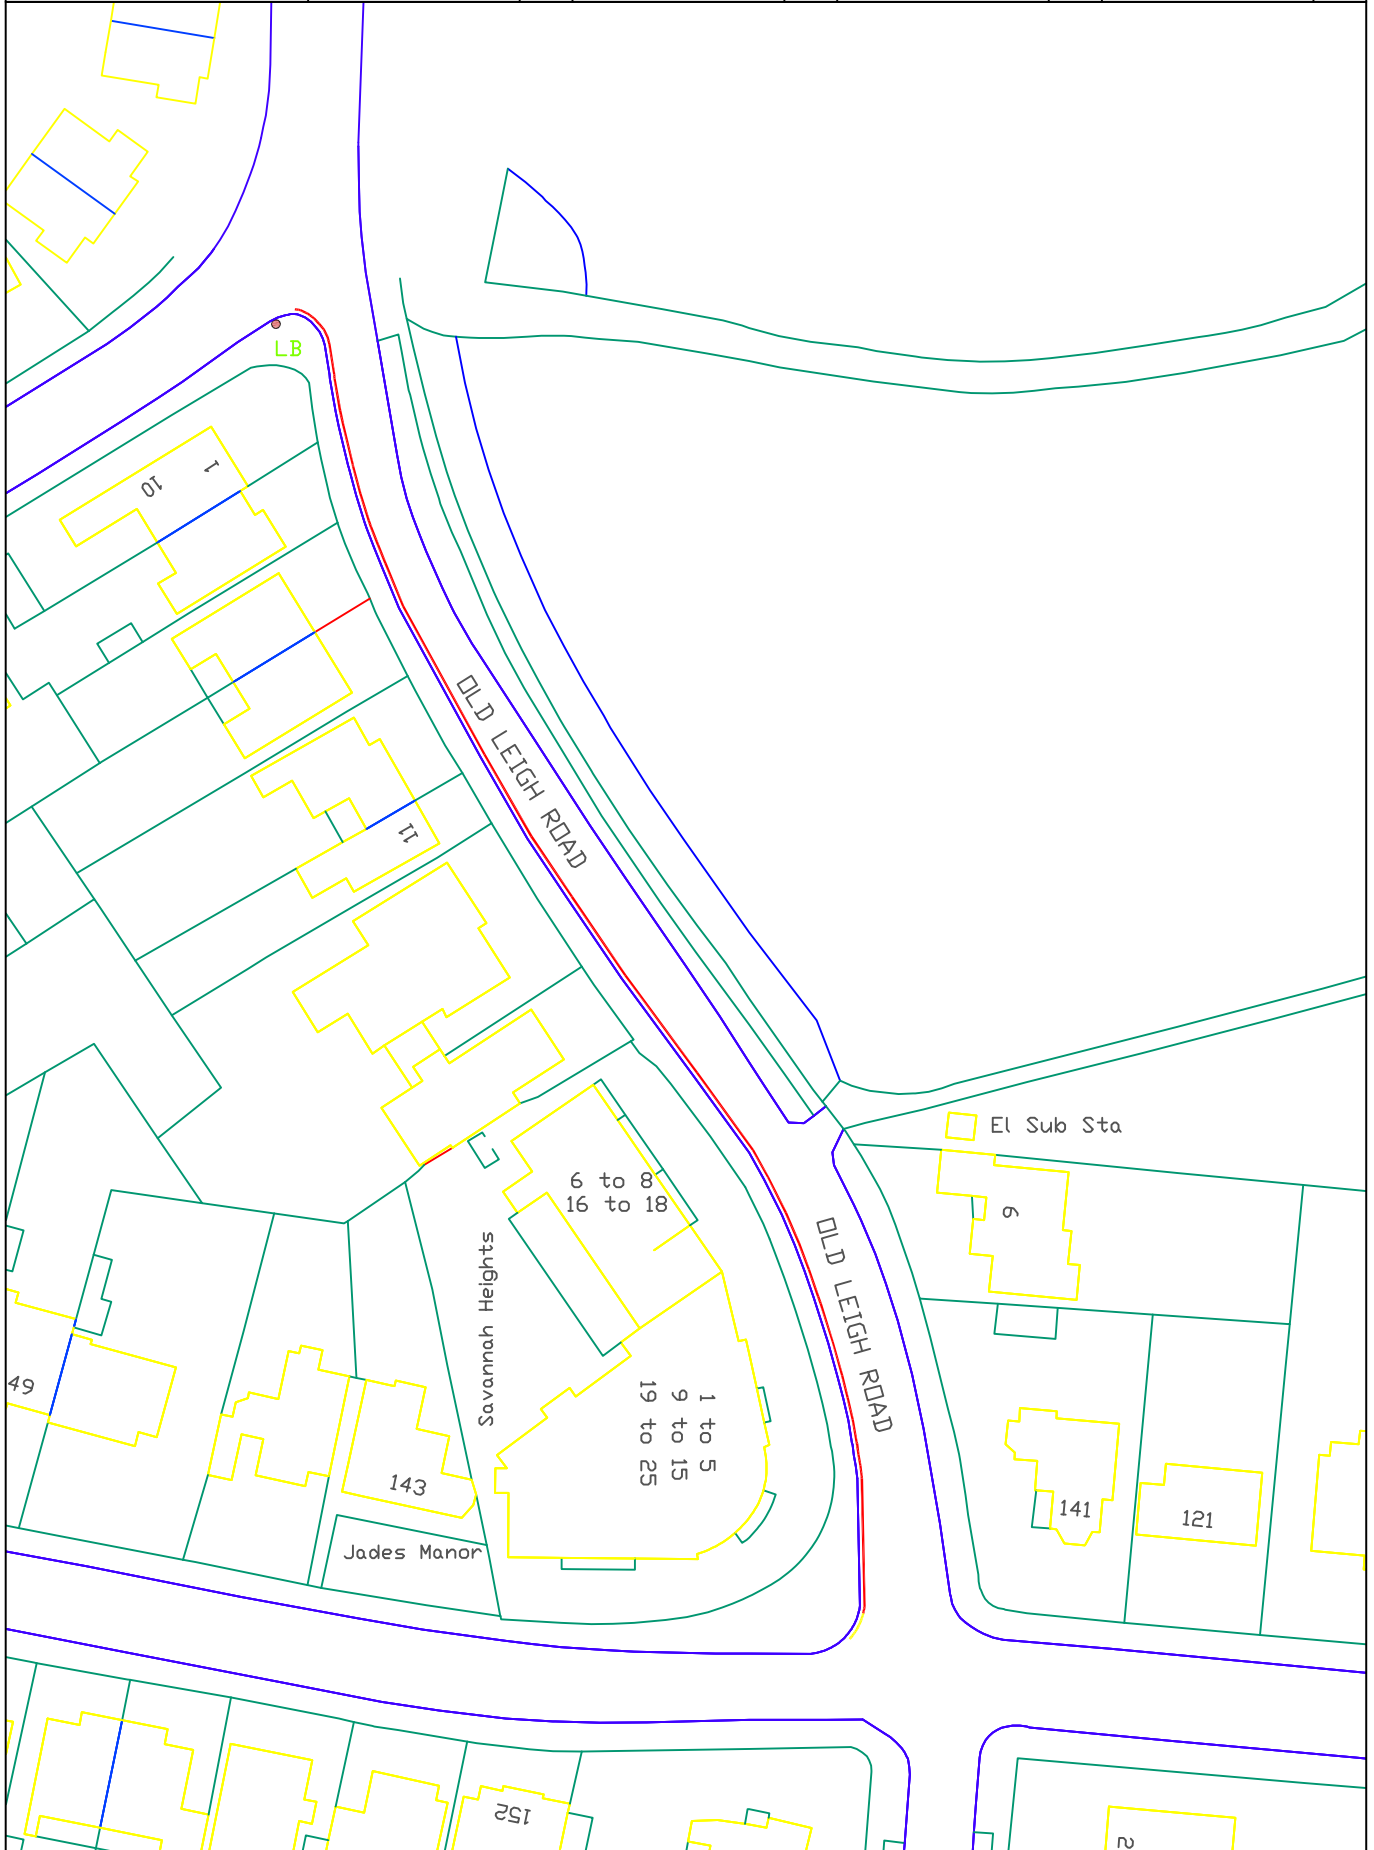

Southend on Sea Borough Council Enterprise, Tourism and the Environment PO Box 5560, Civic Centre Victoria Avenue, Southend on Sea, SS2 6ZQ		Project Title Parking Reviews			Date Nov 08	
		Drawing Title Oakwood Avenue Plan 5			Quality Project No. 00000/00	
		Designed CHT	Drawn by	Checked by	Approved by	Scales not to scale
Drawing Status		Preliminary	Tender	Working	As Constructed	
					Drawing Number CE 9999/ /	

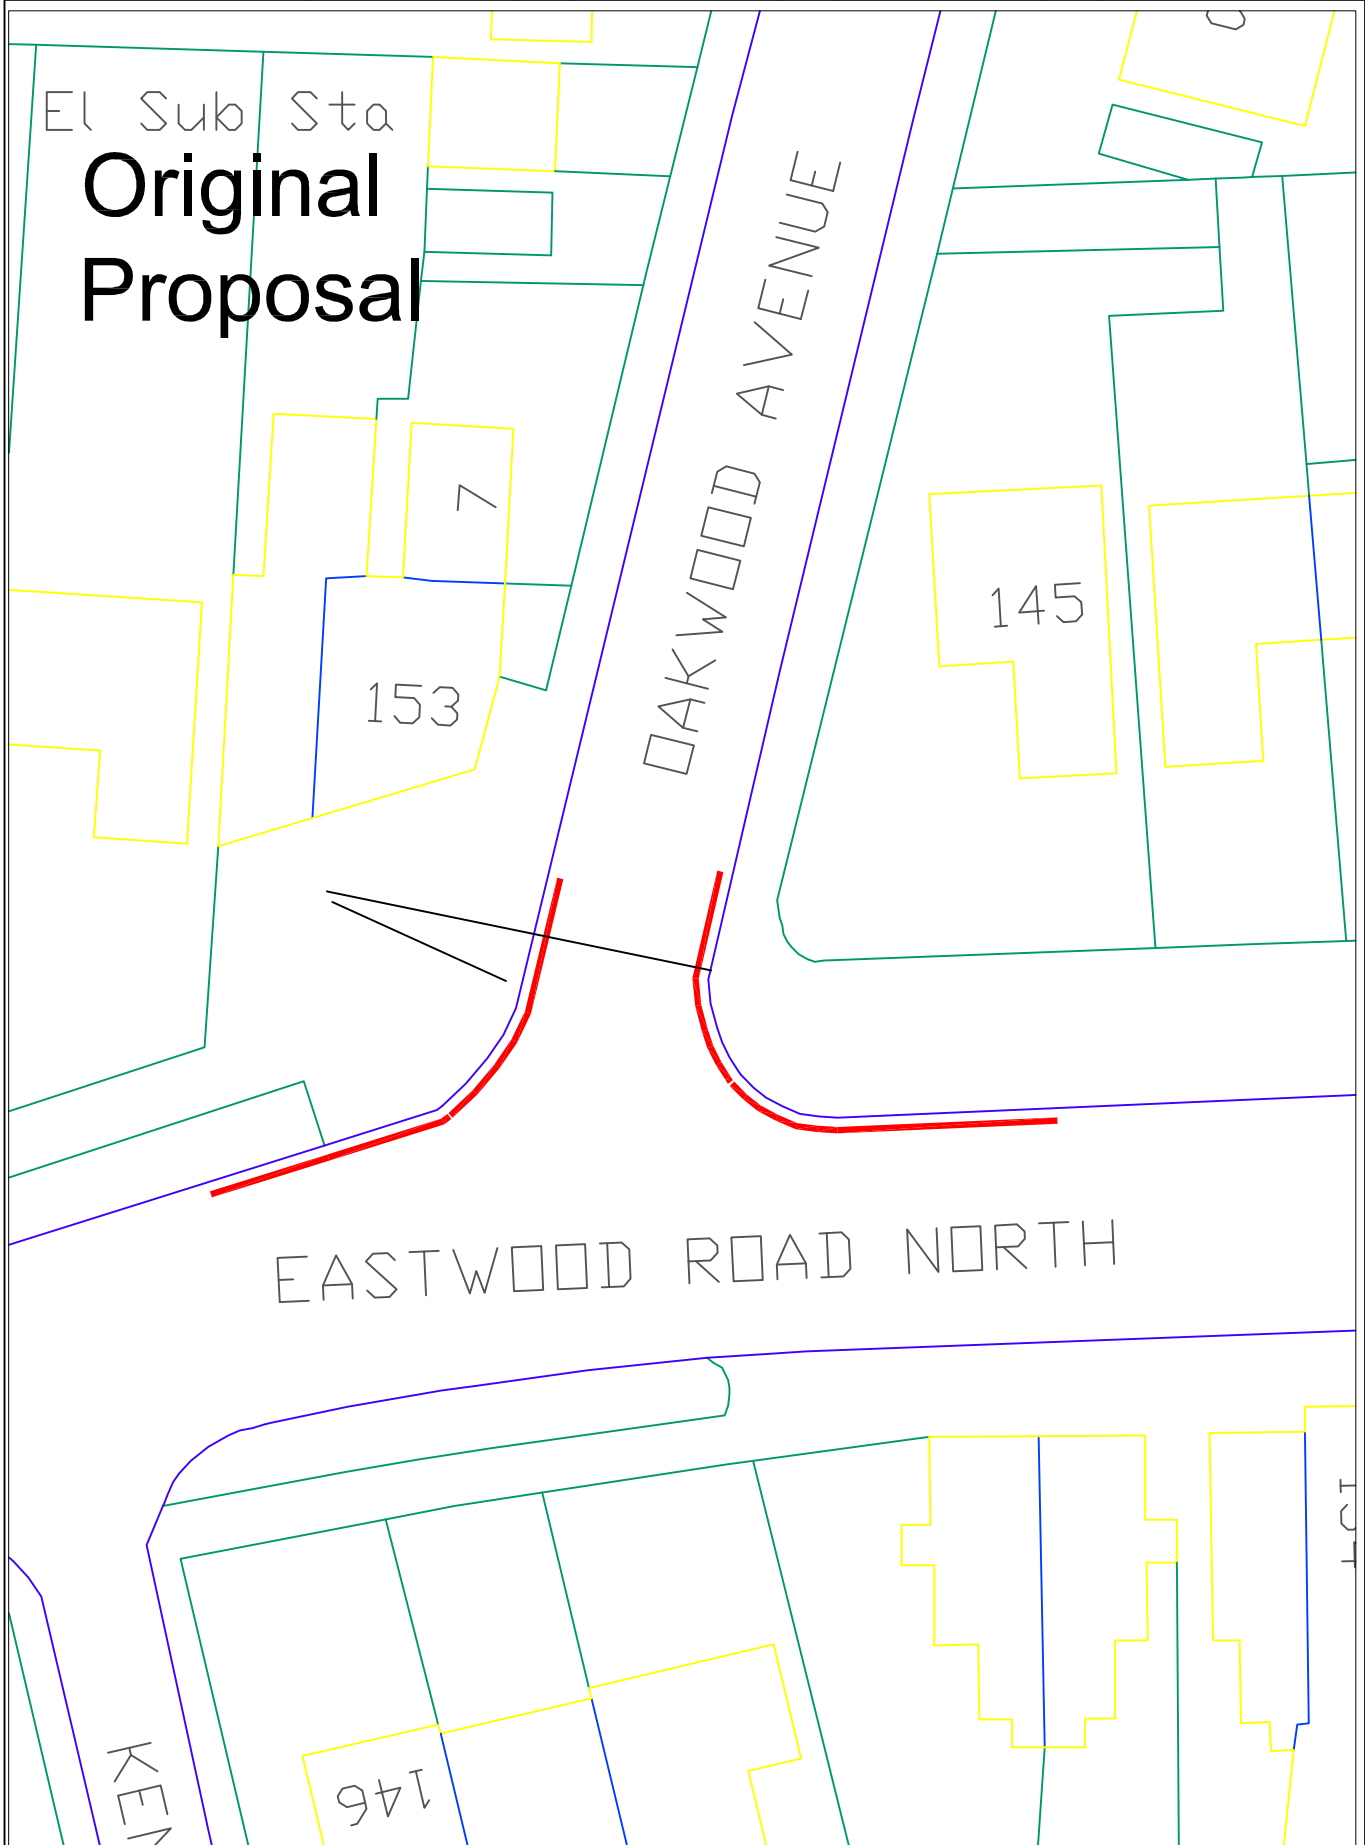

Southend on Sea Borough Council Enterprise, Tourism and the Environment PO Box 5560, Civic Centre Victoria Avenue, Southend on Sea, SS2 6ZQ	Project Title Parking Review				Date Nov 08	
	Drawing Title Wick Chase				Quality Project No. 00000/00	
	Plan 6				Scales not to scale	
	Designed	Drawn by	Checked by	Approved by	Drawing Number CE 9999/ /	

Drawing Status	Preliminary		Tender		Working		As Constructed	
----------------	-------------	--	--------	--	---------	--	----------------	--

