




APPENDIX 1

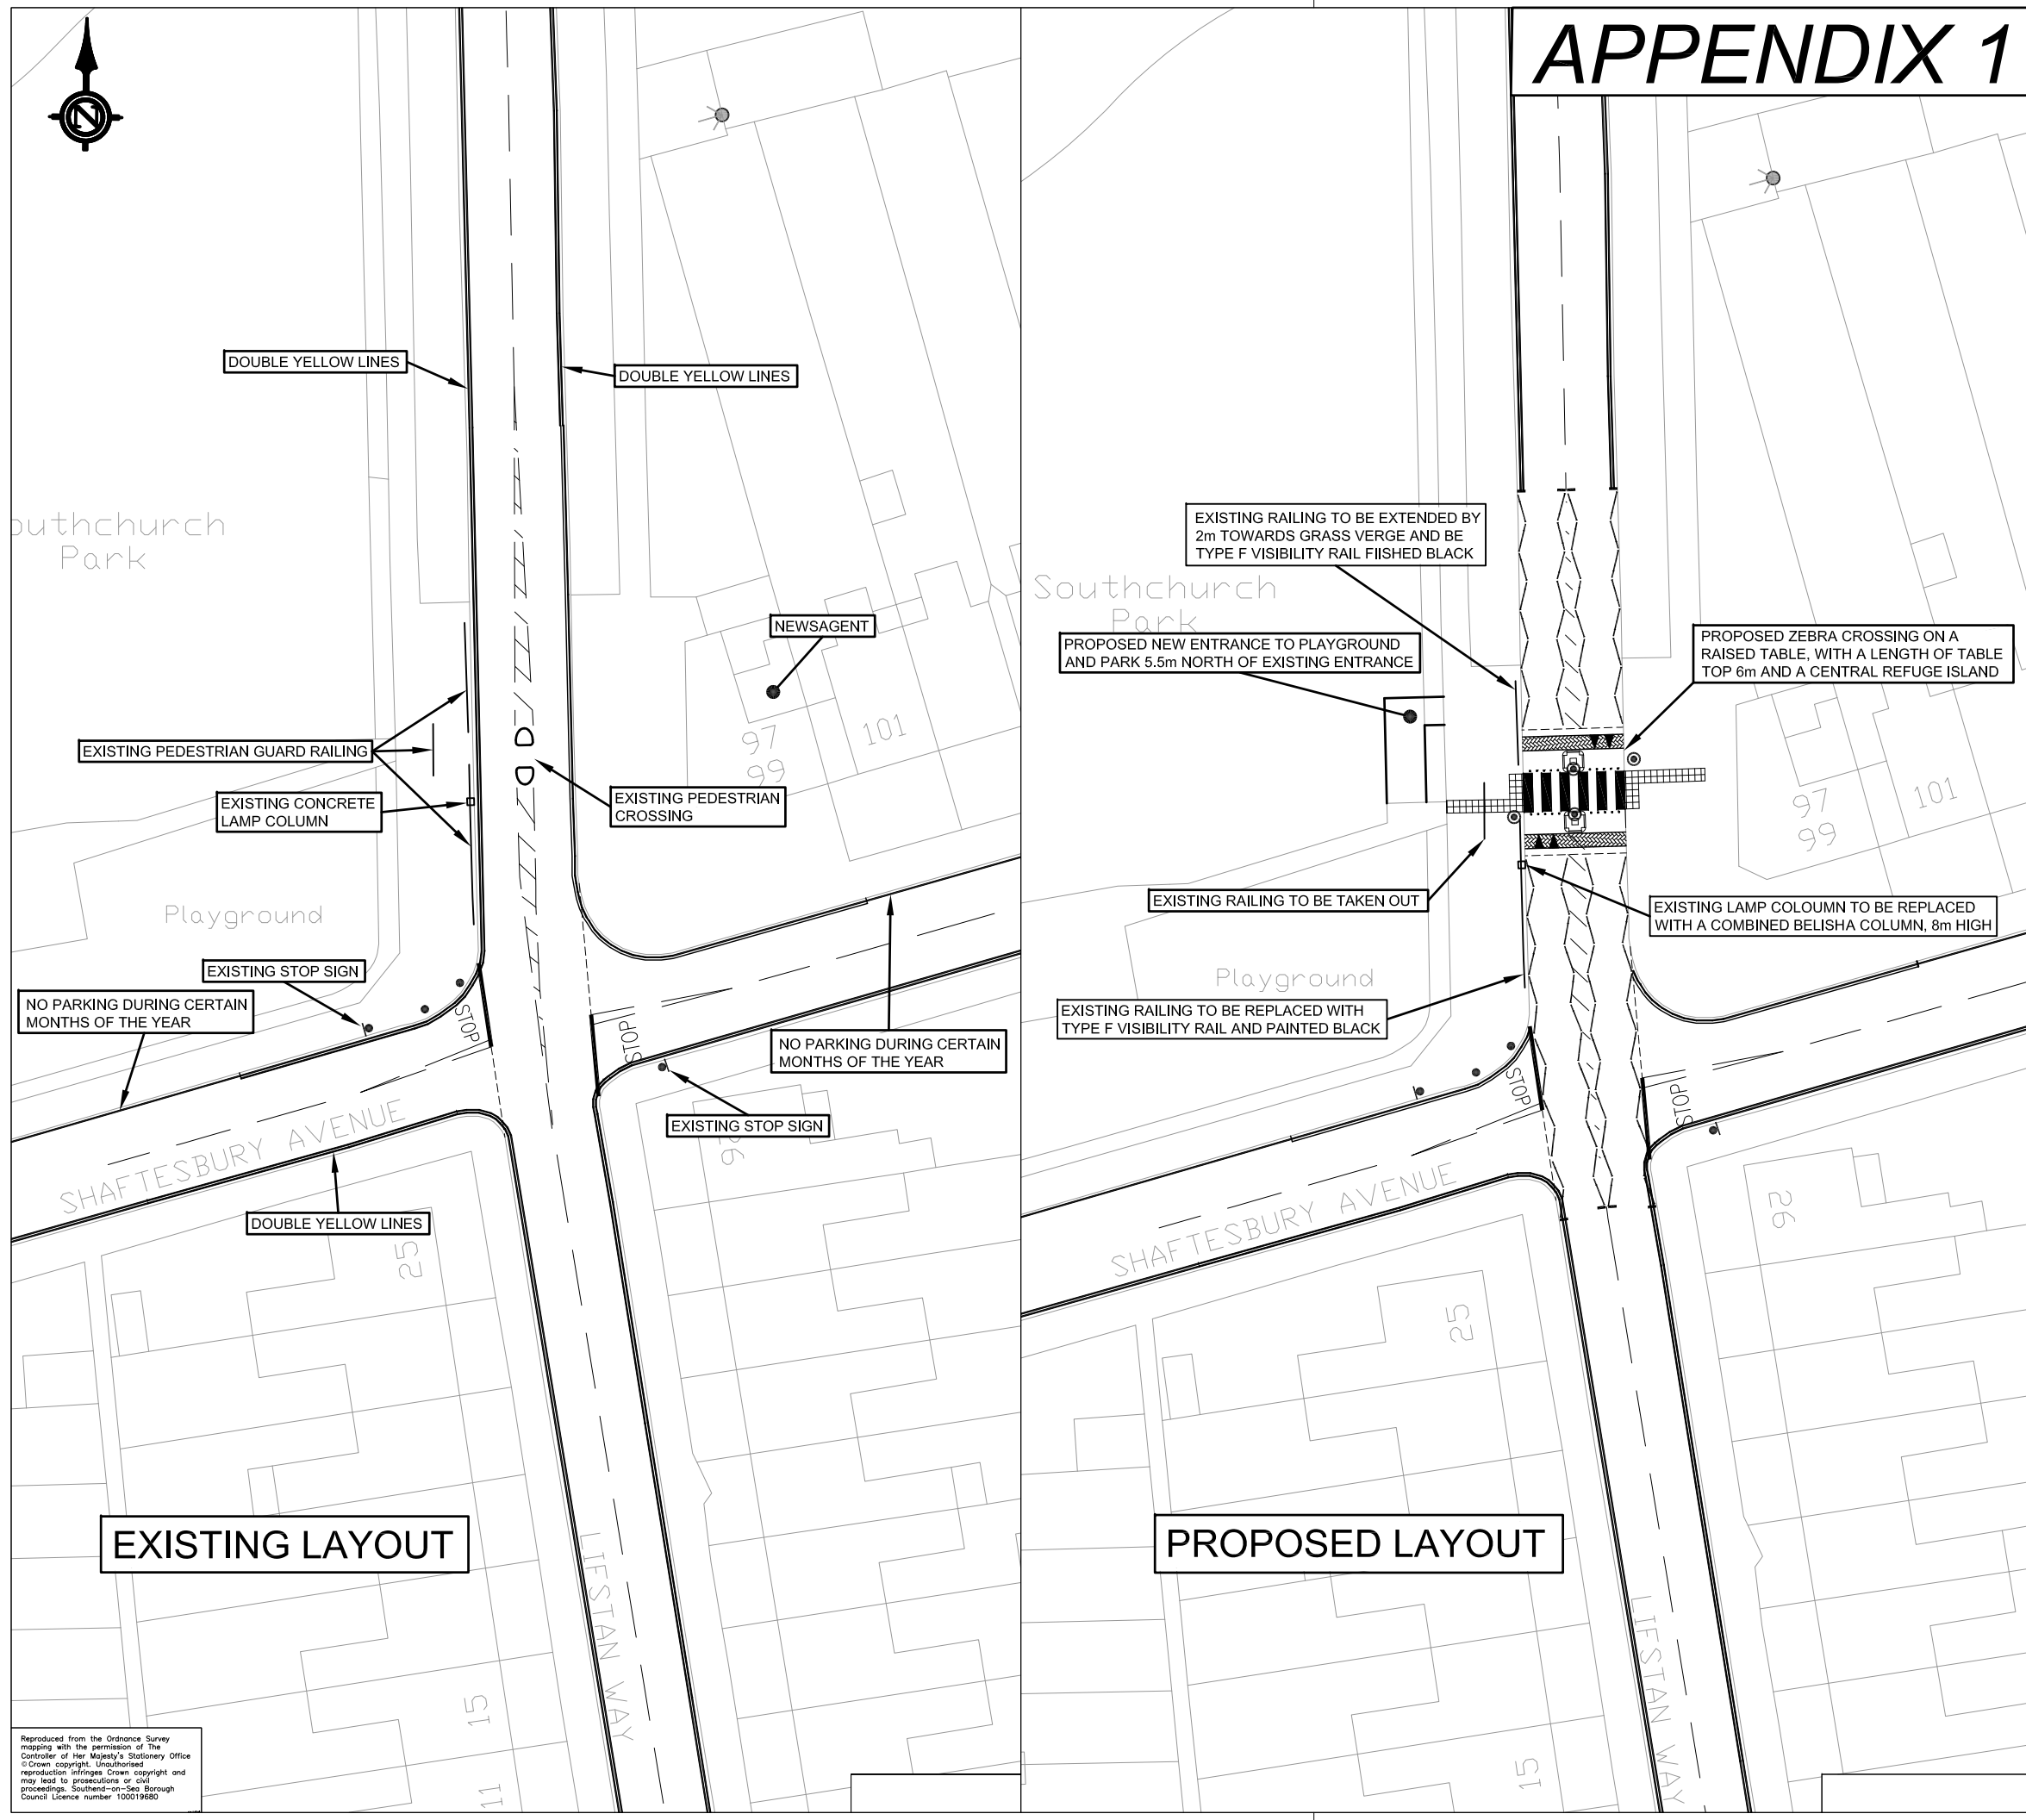

Ref.	Revisions	Date
No.	Copies sent to	Date

Southend-on-Sea Borough Council
 Enterprise, Tourism and the Environment
 PO Box 5560, Civic Centre
 Victoria Avenue, Southend on Sea,
 SS2 6ZQ

Quality Project No. : #####

Project Title
LIFSTAN WAY NORTH OF SHAFTESBURY AVENUE

Drawing Title
IMPROVEMENTS TO CROSSING FACILITY

Designed by C NORMAN		Scales	
Drawn CN	Date 18/06/09	NTS	
Checked PH	Date 22 / 06 / 09		
Approved PH	Date 23 / 06 / 09	Issued	Date

Drawing Status			
Preliminary	Working		
Tender	As Constructed		

Drawing Number
CD5004/24

Reproduced from the Ordnance Survey mapping with the permission of the Controller of Her Majesty's Stationery Office. Crown copyright. Unauthorised reproduction infringes Crown copyright and may lead to prosecutions or civil proceedings. Southend-on-Sea Borough Council Licence number 100019680