



OS map

Scale - 1:1250

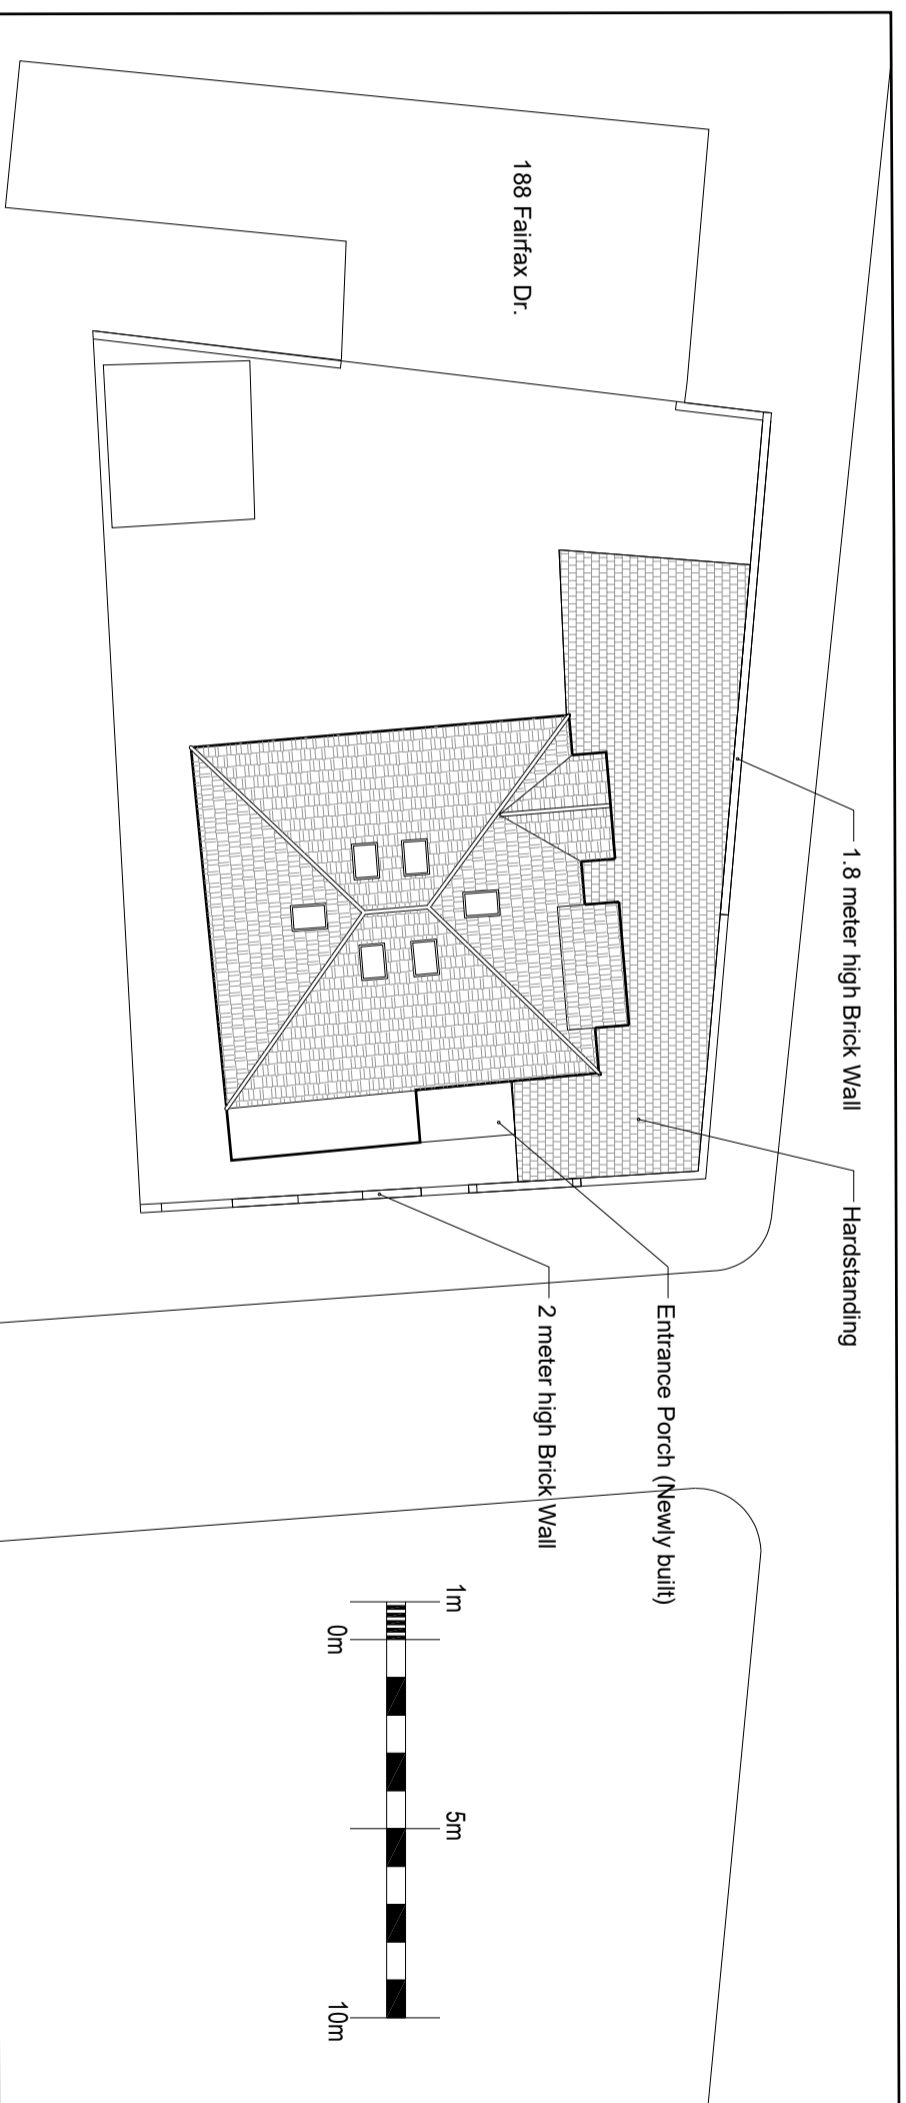

Block Plan (As-built)

Scale - 1:200

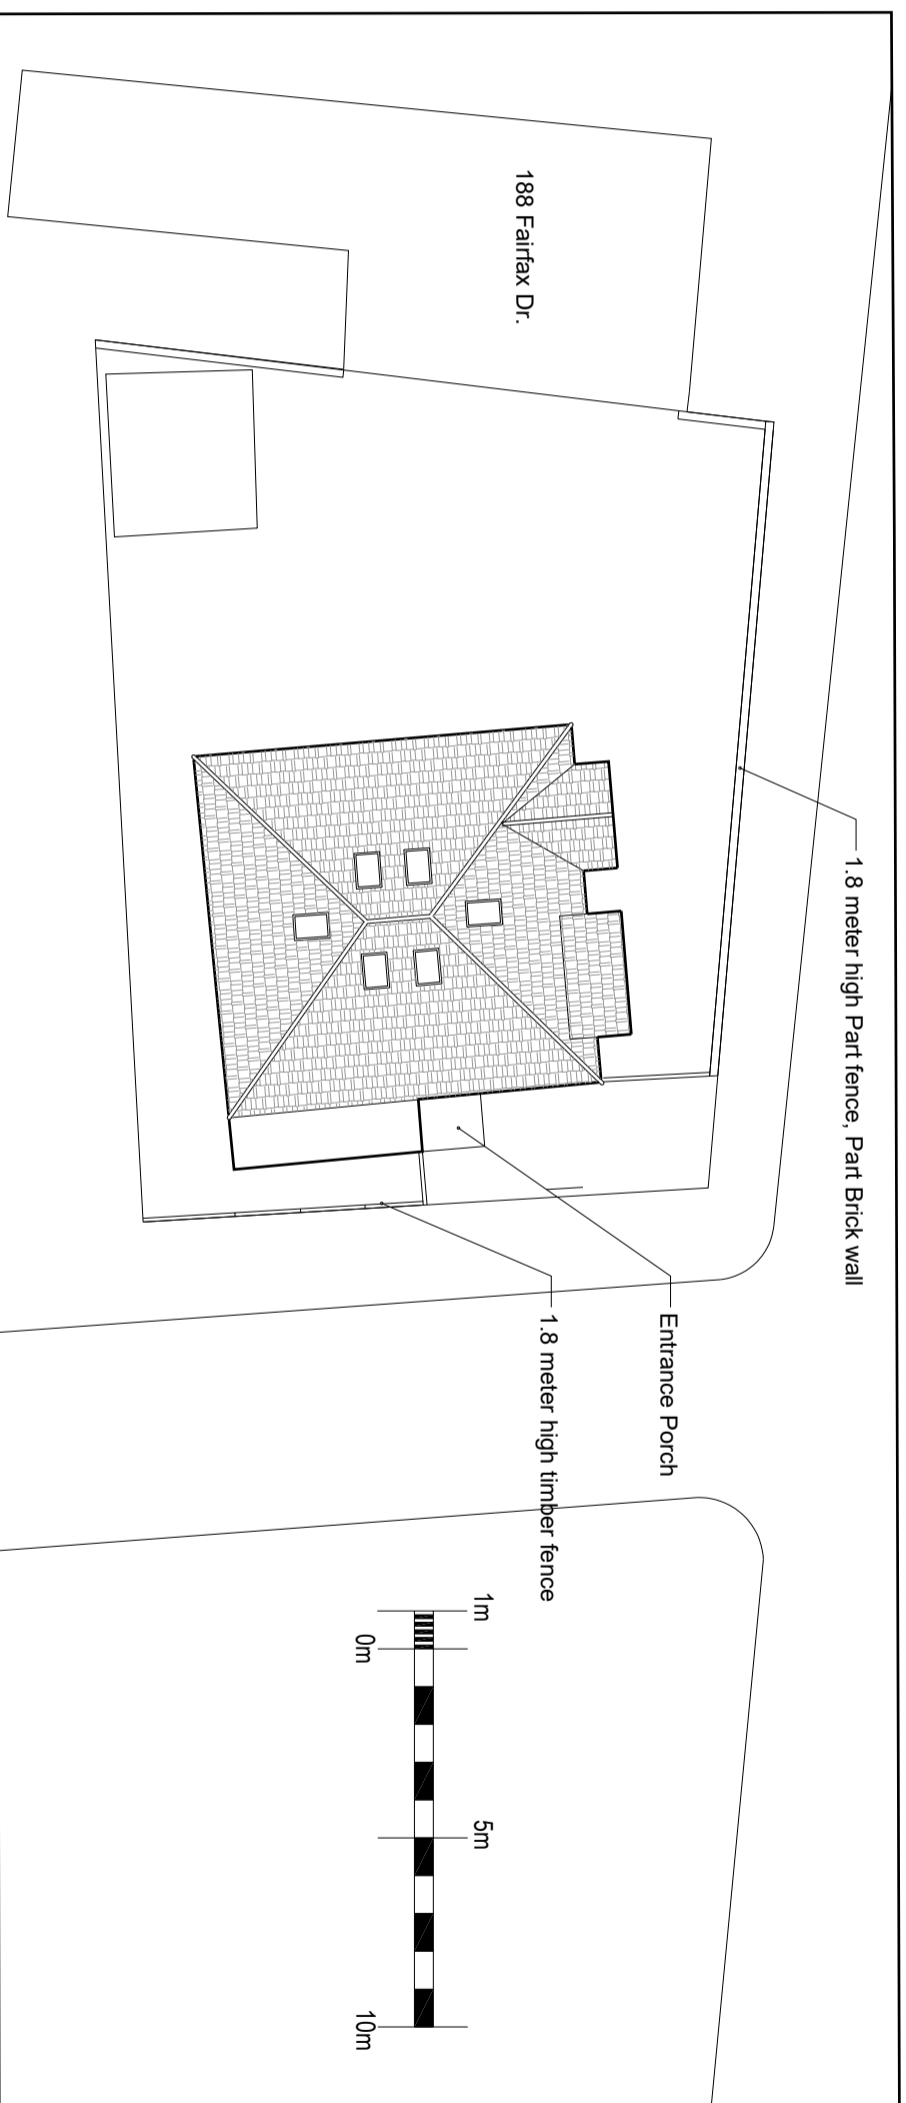

Block Plan

Scale - 1:200



141 Inverness Avenue
WESTCLIFF-ON-SEA
SS0 9DU

Dwg No.
AL(00)001

Rev.

Title
OS Map and Block Plan

Date Drawn Check Status
20/03/23 RA RA RA Planning

Scale
varies@A3