



Original Elevation (From Fairfax Drive)

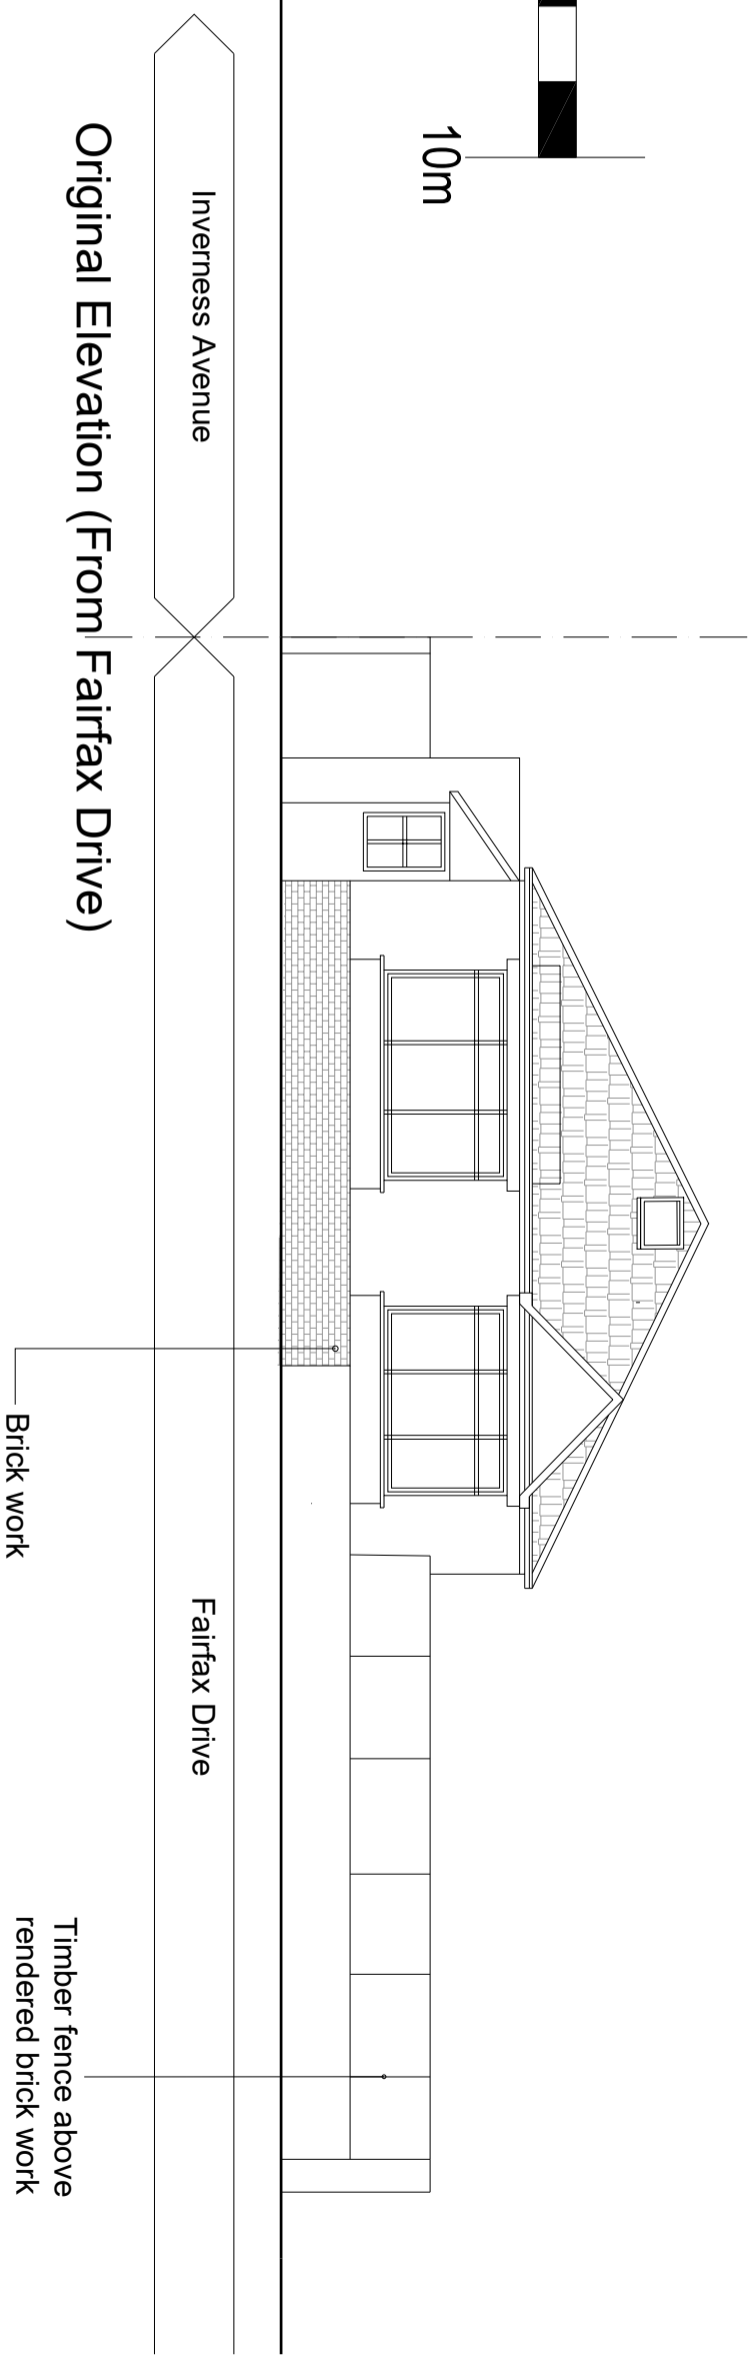

As built Elevation (From Fairfax Drive)

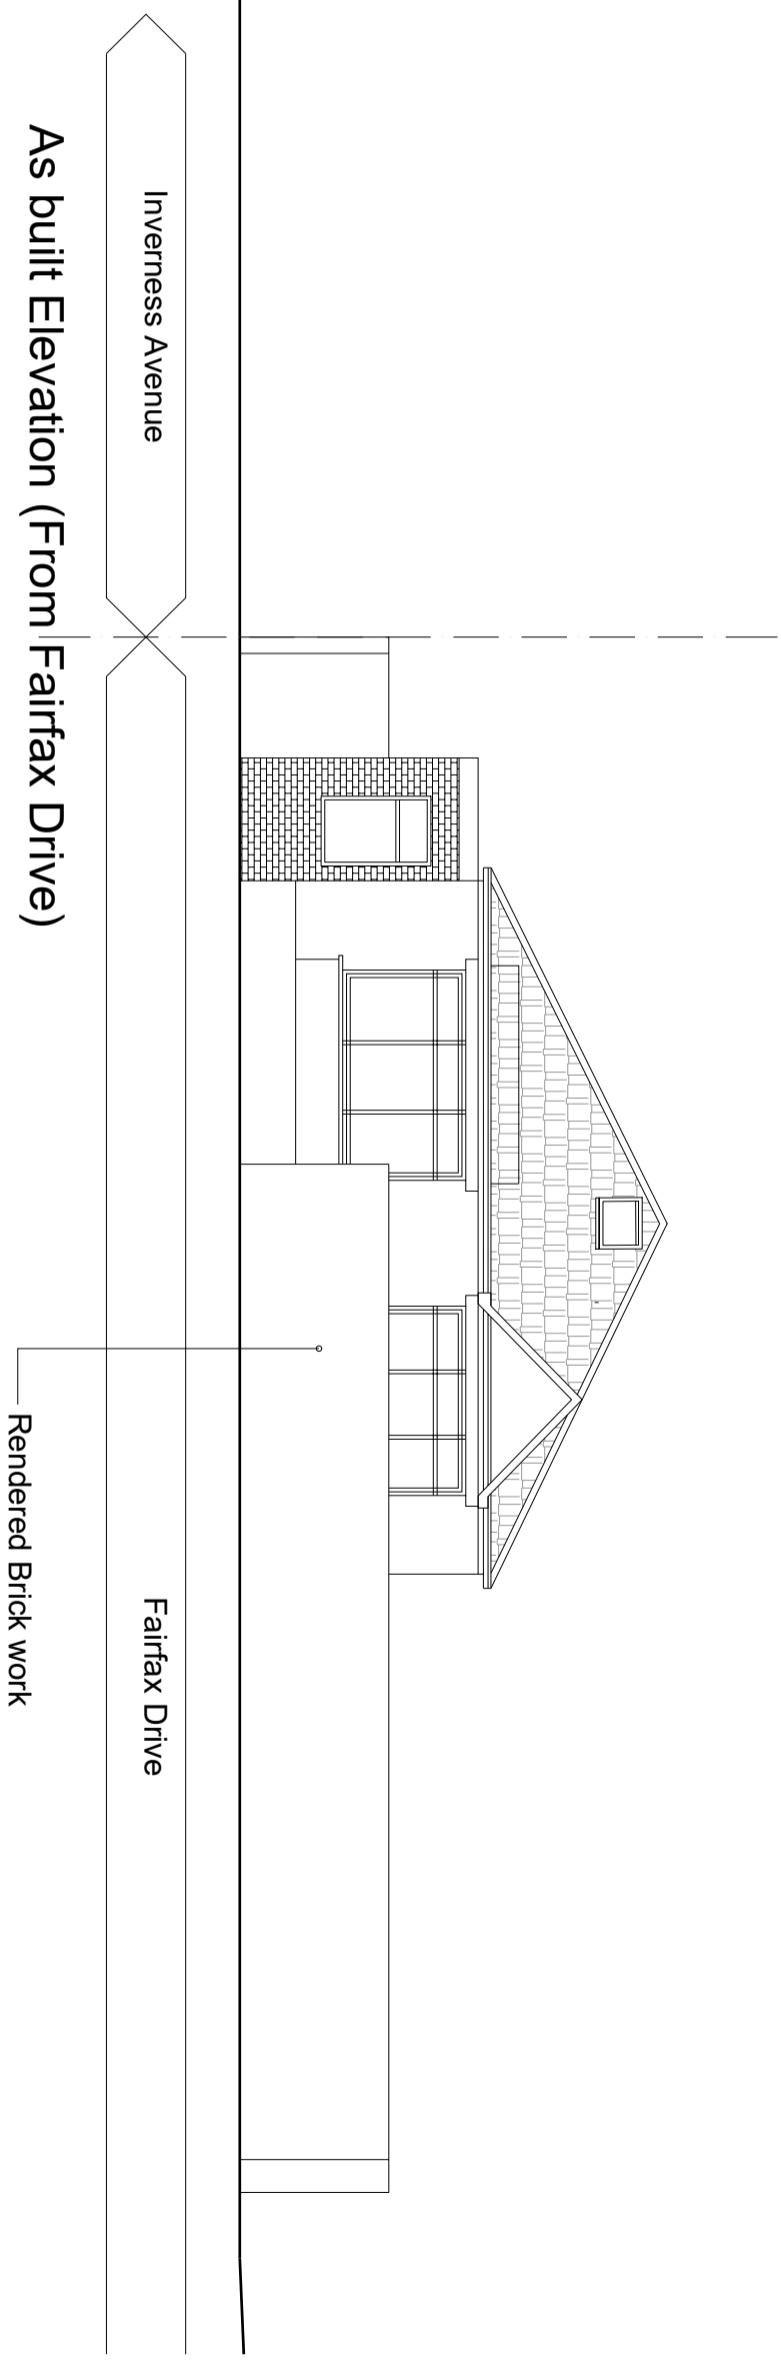

141 Inverness Avenue		Dwg No.		Rev.	
WESTCLIFF-ON-SEA		AL(00)003			
SS0 9DU					
Title					
Original and As built Elevations (Fairfax Drive Road)					
Date	Drawn	Check	Status	Scale	
20/03/23	RA	RA	Planning	1:00@A3	