



Original Elevation (From Inverness Avenue)

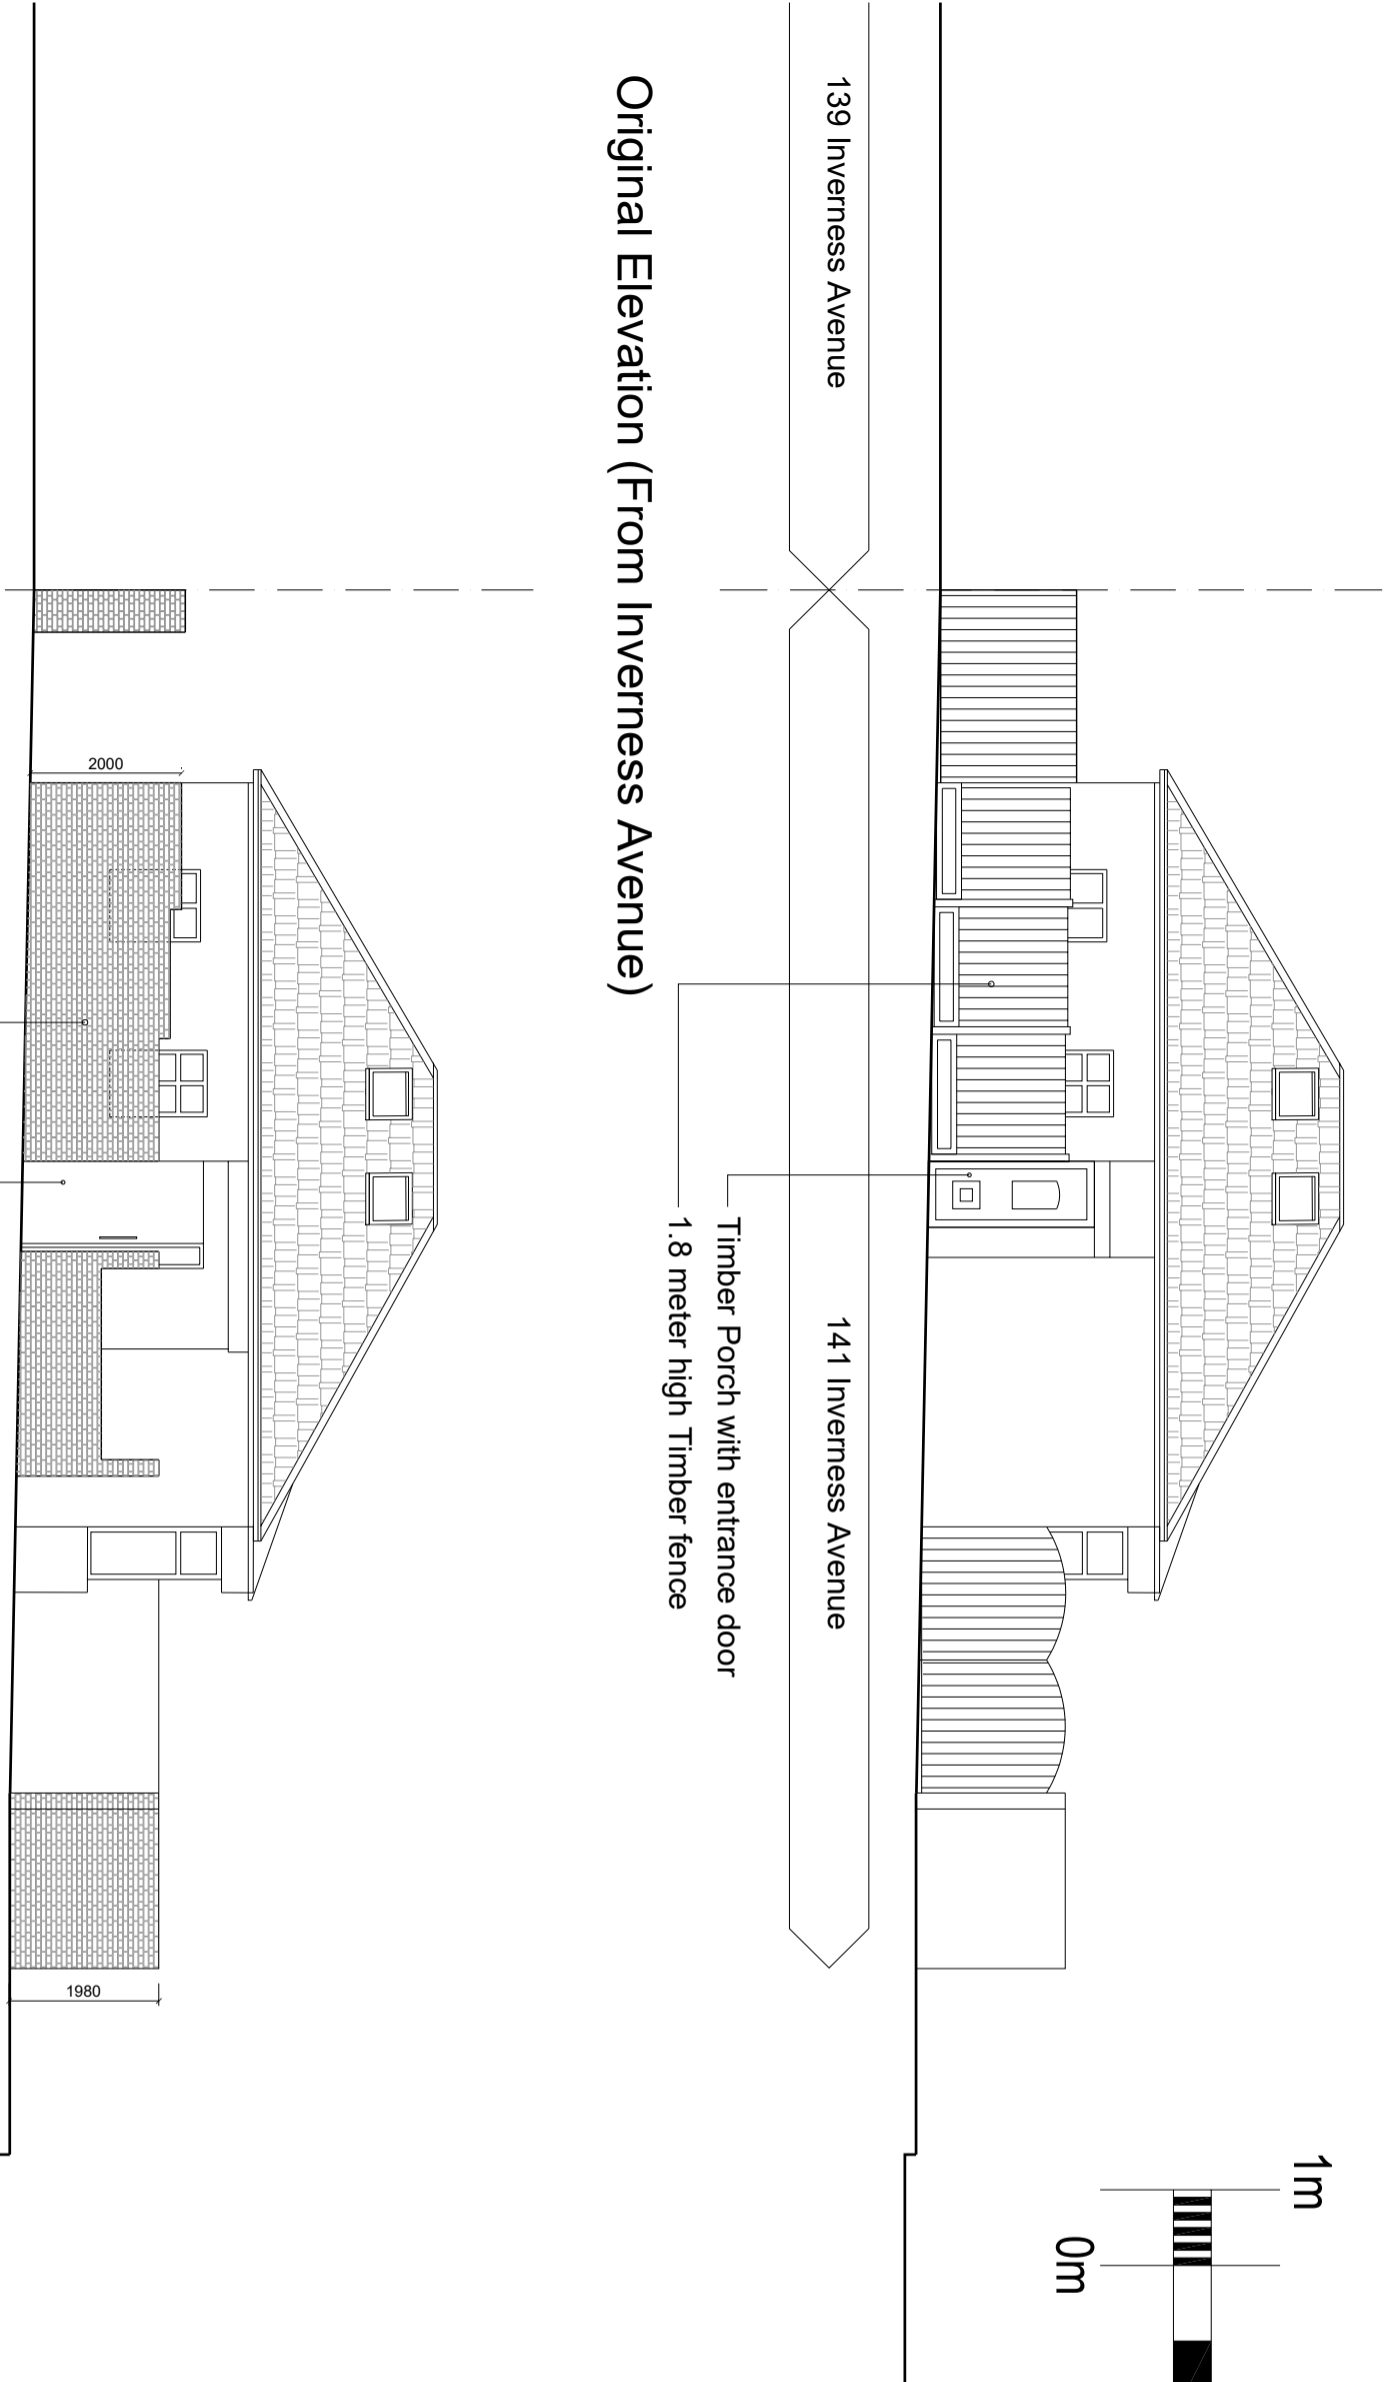

As built Elevation (From Inverness Avenue)

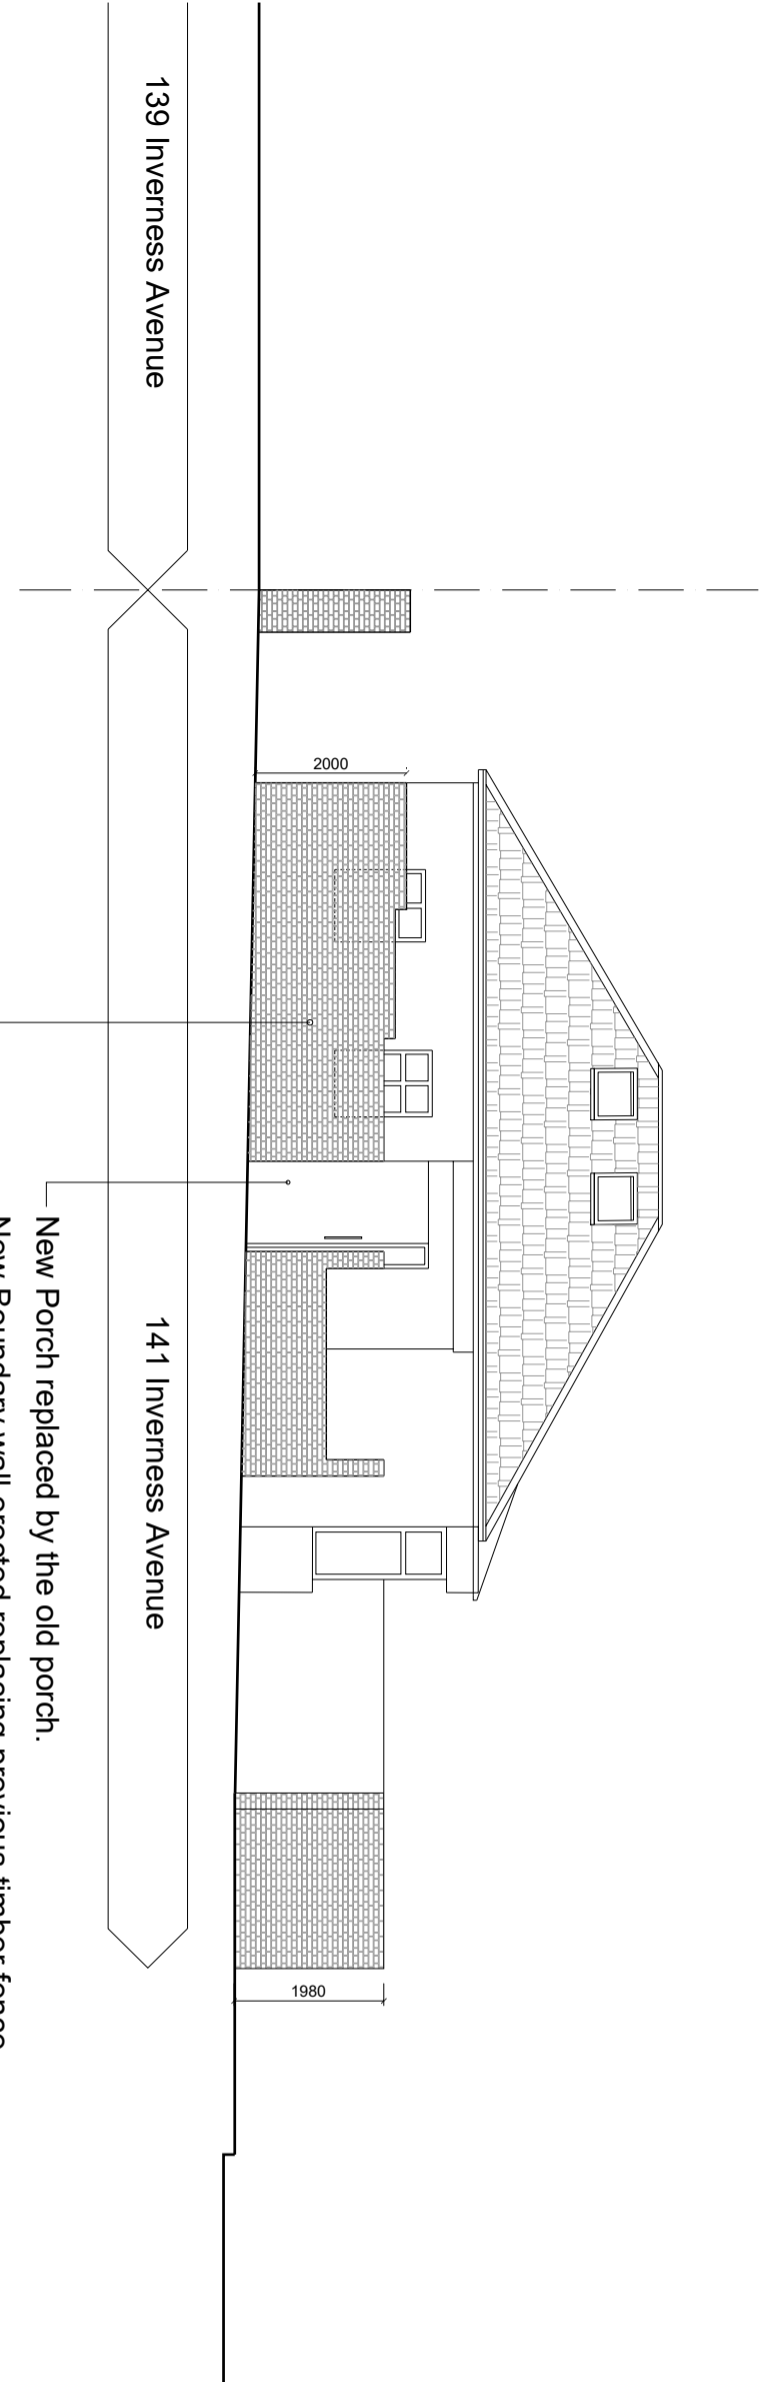

141 Inverness Avenue		Dwg No.	
WESTCLIFF-ON-SEA		AL(00)002	
SS0 9DU		Rev.	
		A	
Title			
Original and As built Elevations (Inverness Road)			
Date	Drawn	Status	Scale
20/03/23	RA	RA	1:00@A3
	RA	Planning	

