

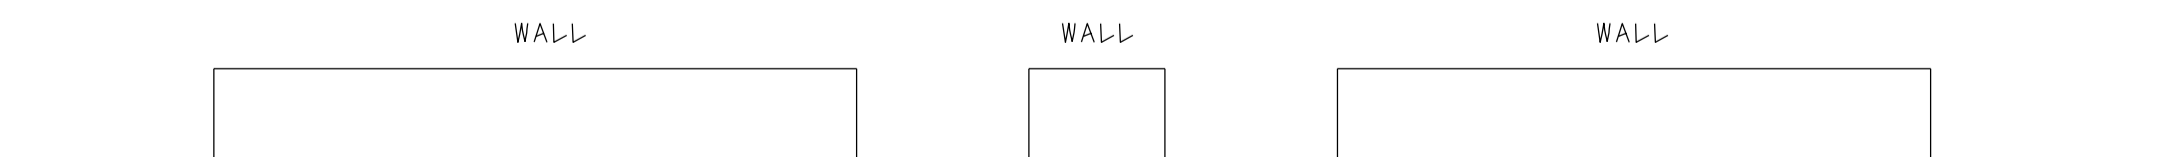



Existing Plan 1:100

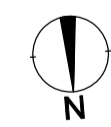


Existing Elevation 1:100

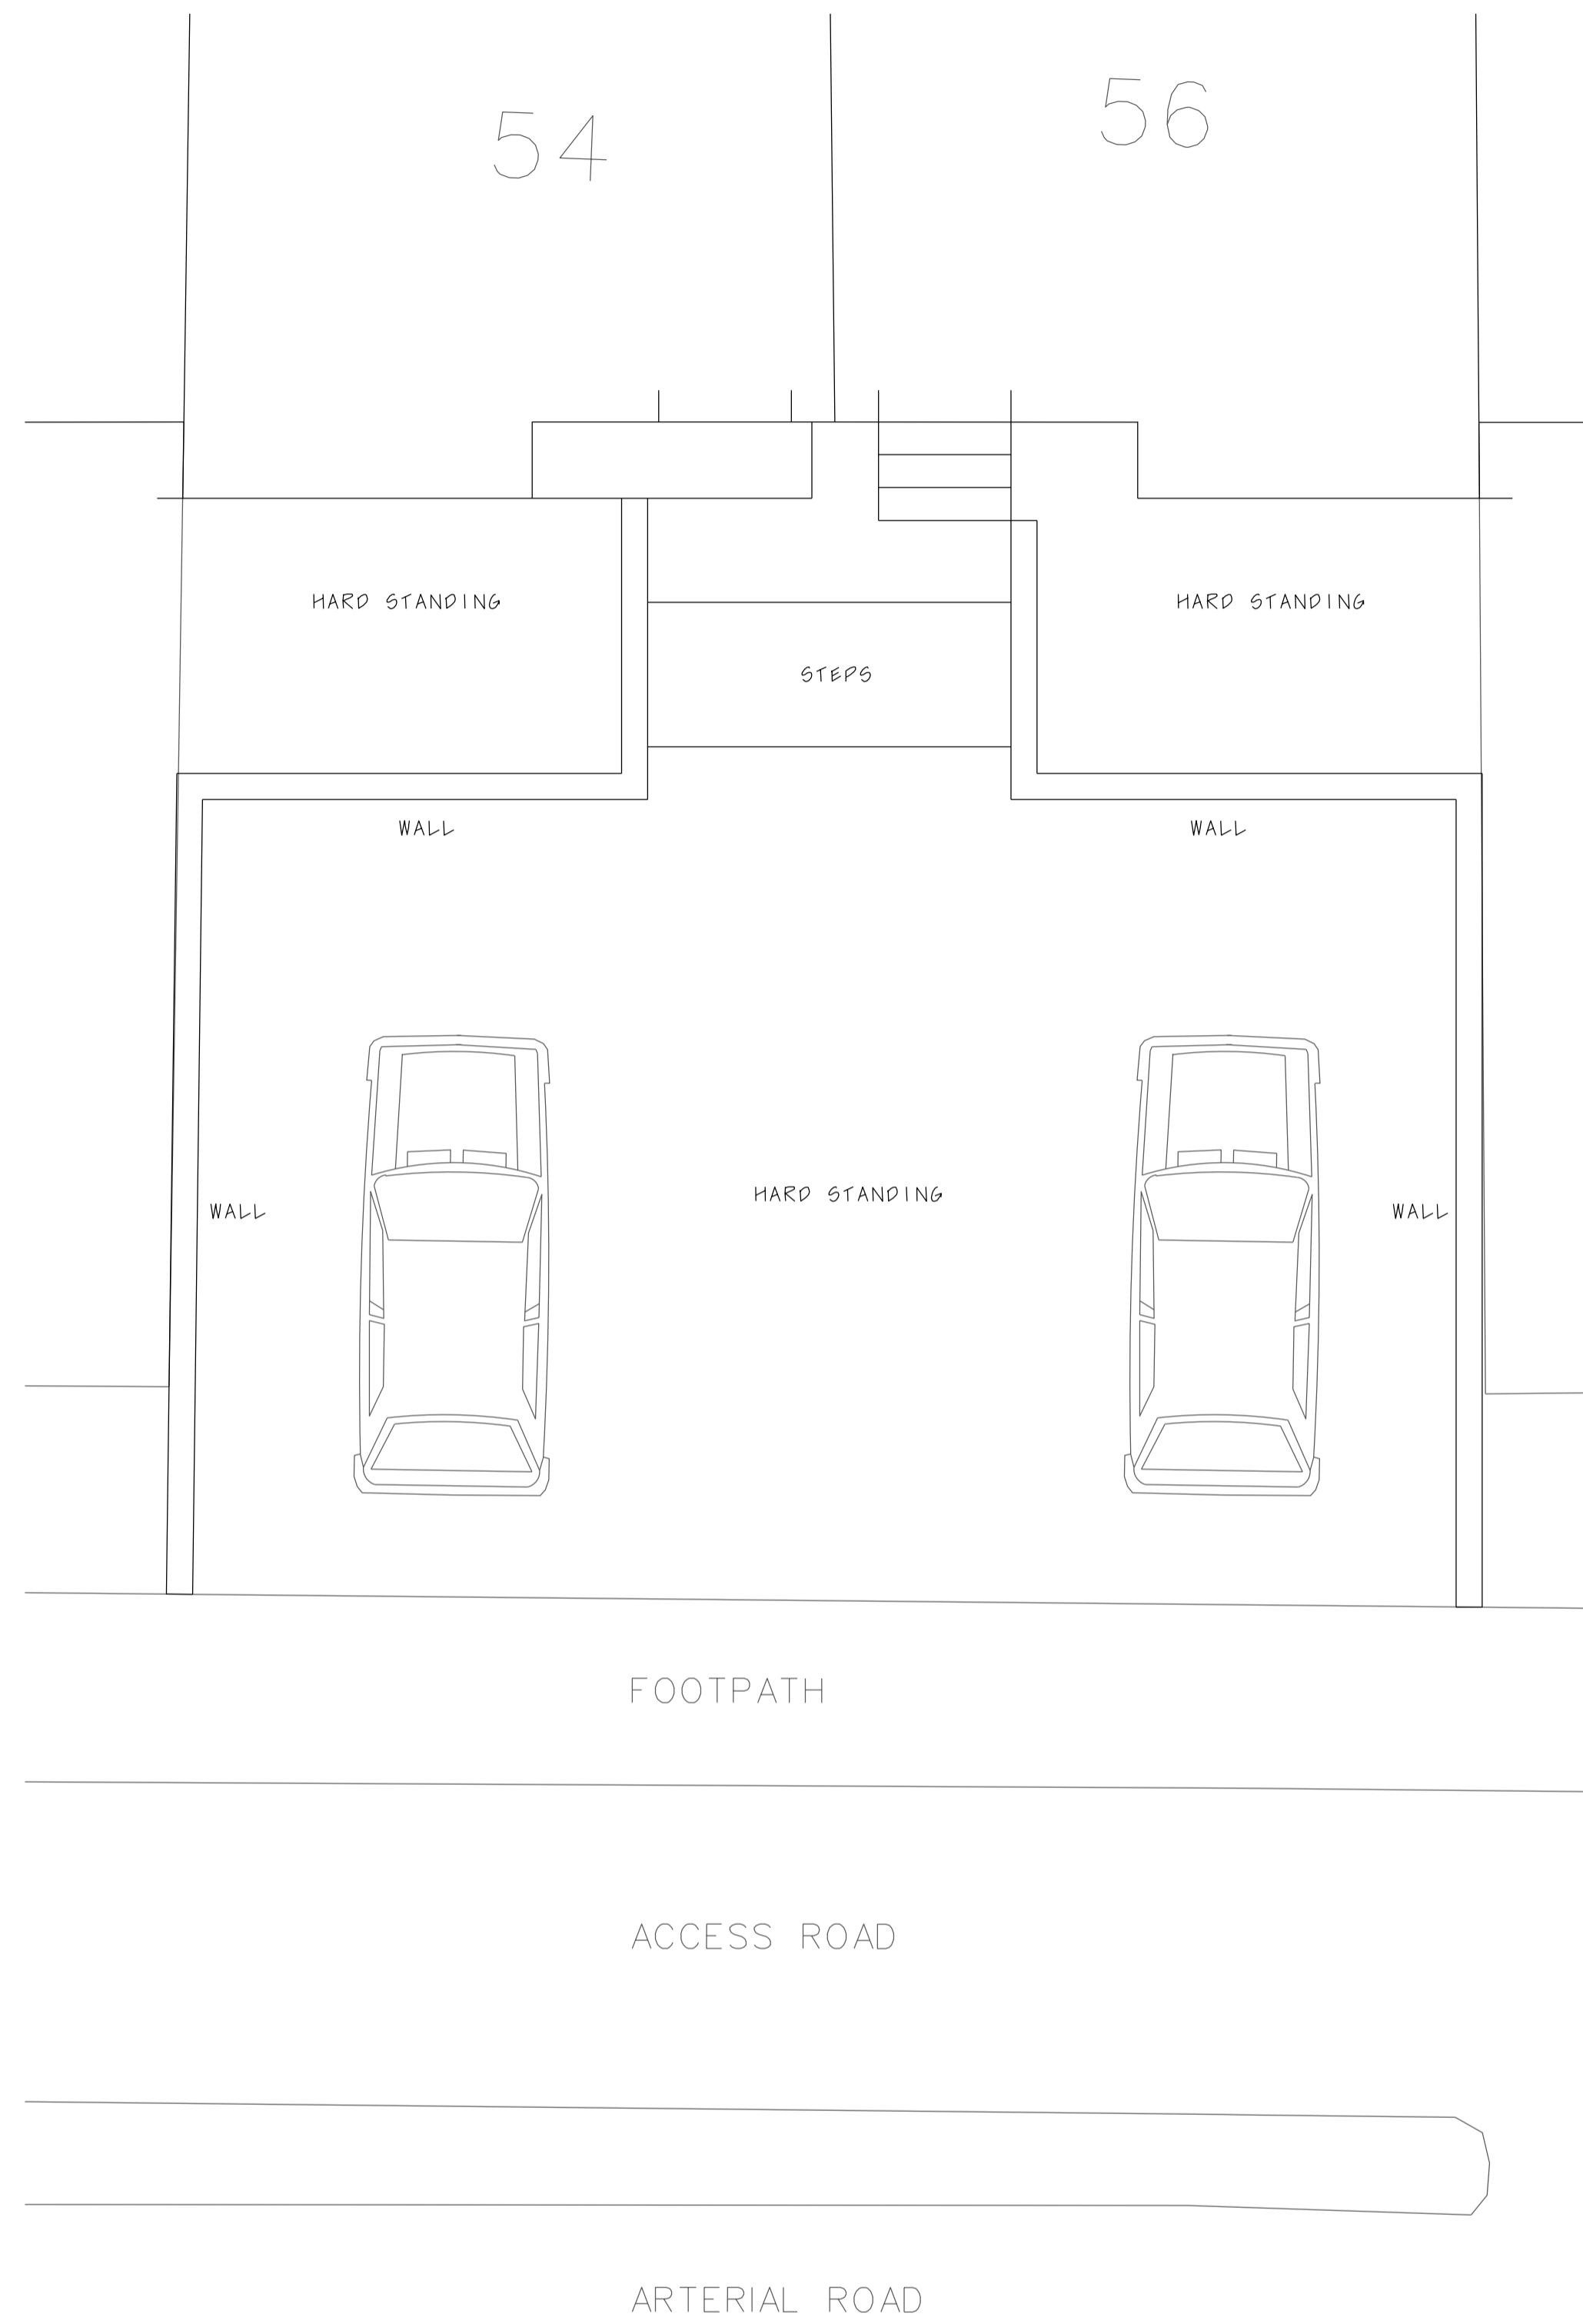


Current as Built Plan 1:100

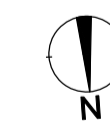

Proposed Elevation 1:100

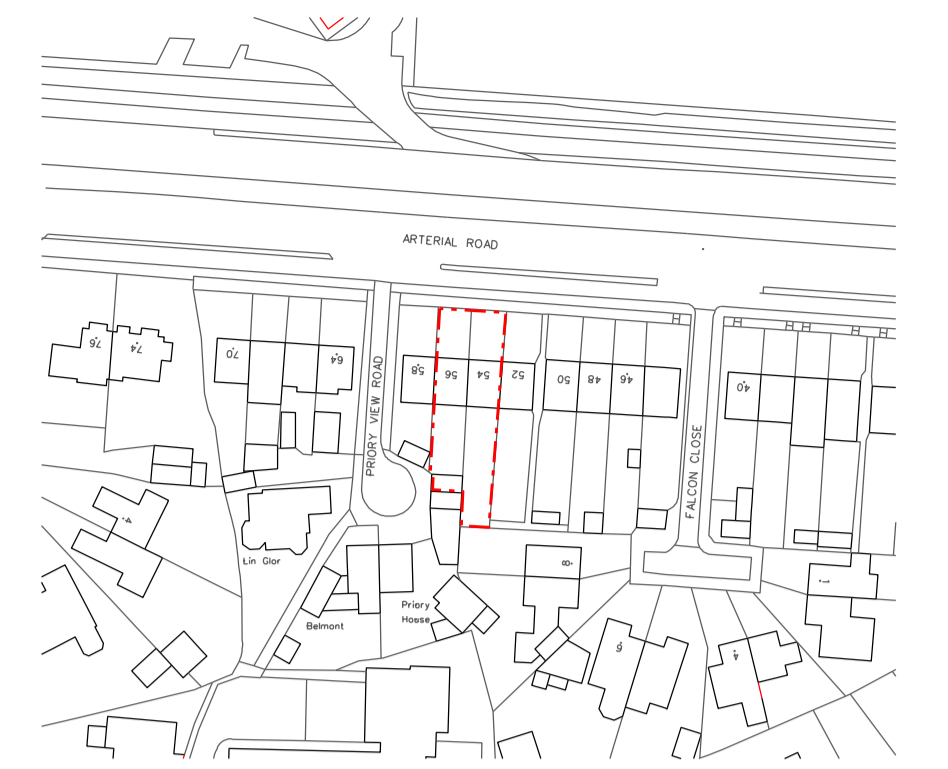

1:1250 Location Plan

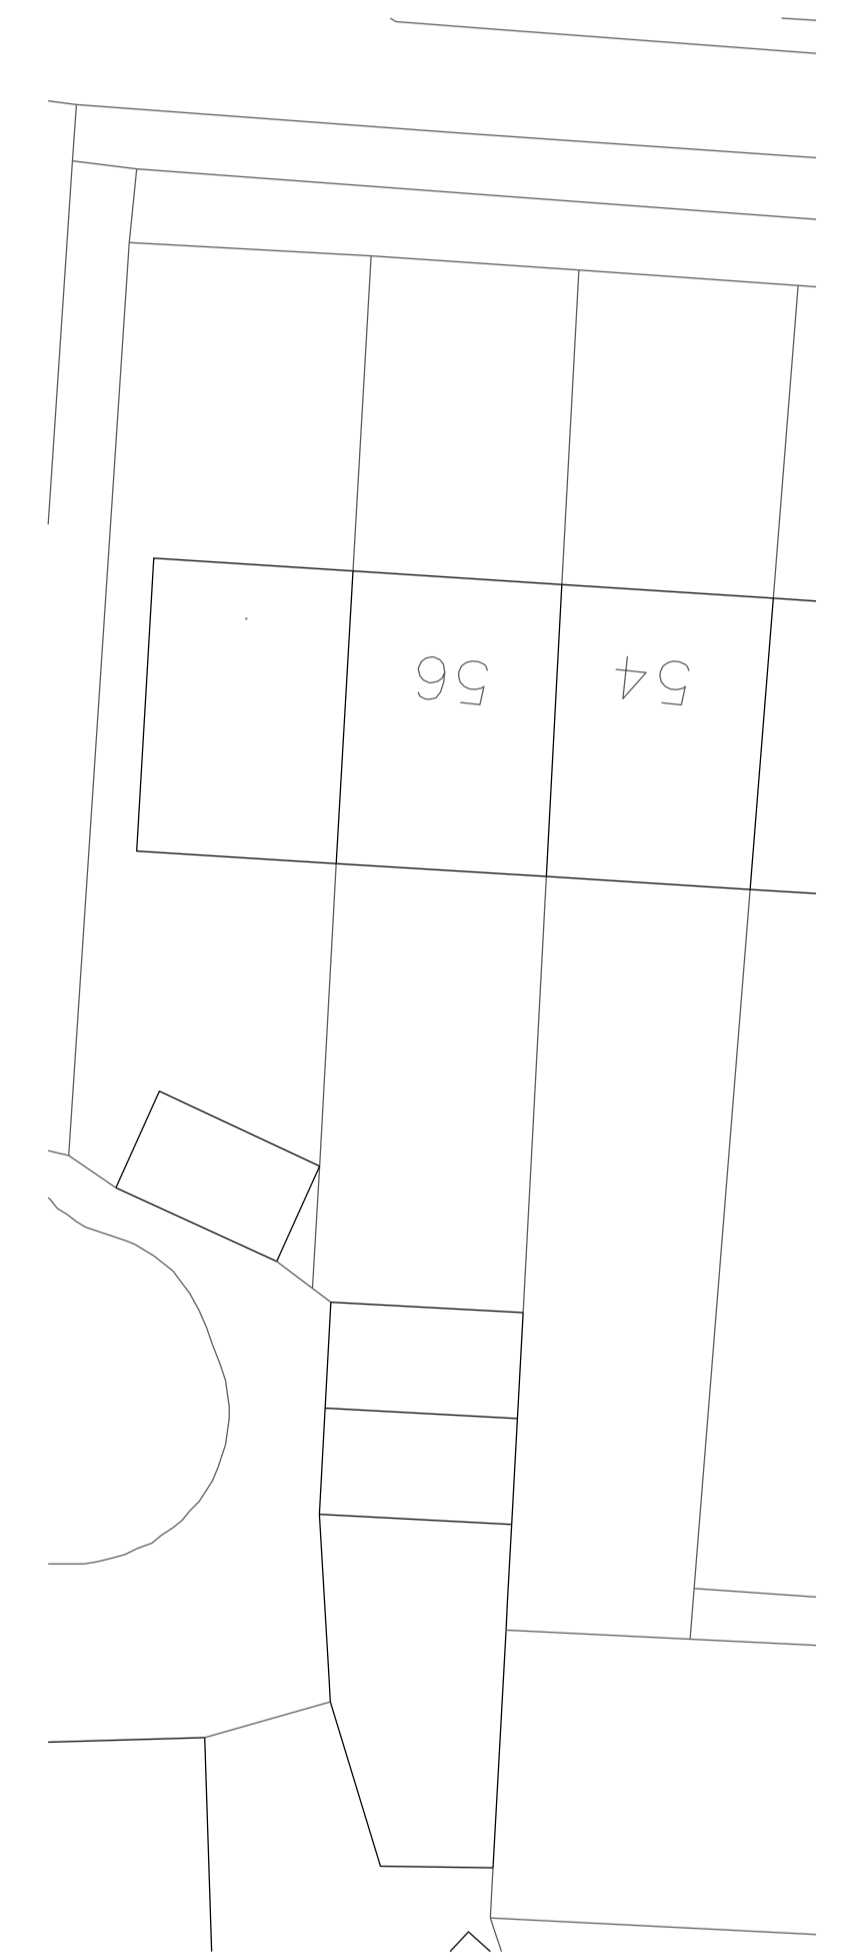

1:200 Site Plan



pa design

Independent architectural services
52 Bailey Road | Leigh on Sea | Essex | SS9 3PJ | M:07790 069168

Project: 54 & 56 Arterial Road Leigh on Sea SS9 4DA

Client: Mr F Sancarlio

Drawing title: Proposed Off Street Parking

Scale 1: 50@A1 100@A3

Drawn by PSA

Project number 21 507 Drawing number P10

Status: Planning Approval - Joint Application

All dimensions must be checked on site and not scaled from this drawing.