
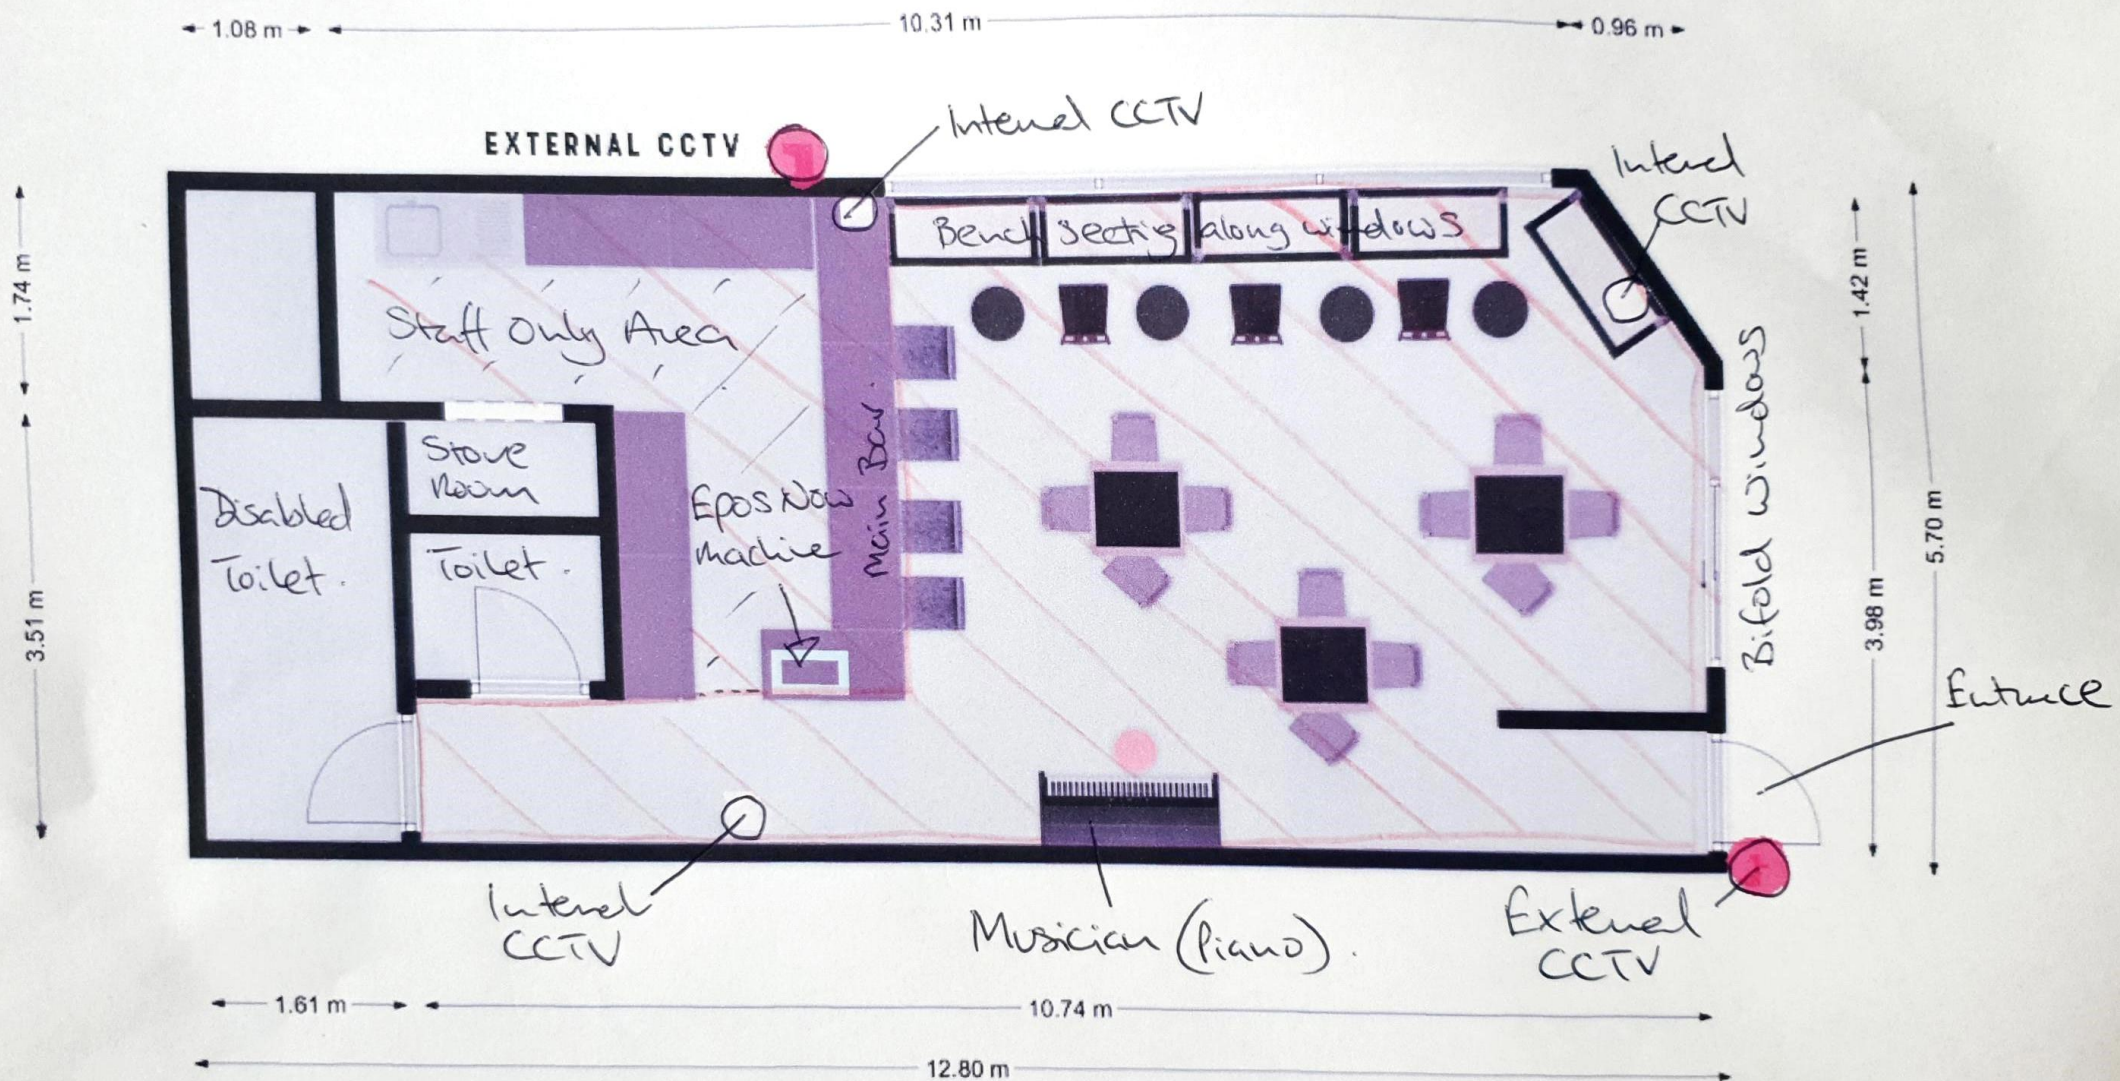


128A Hamlet Court Road - Westchiff Drinks Co.

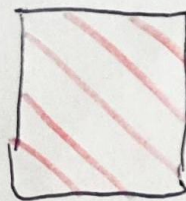

 Red lines indicate licensed area.