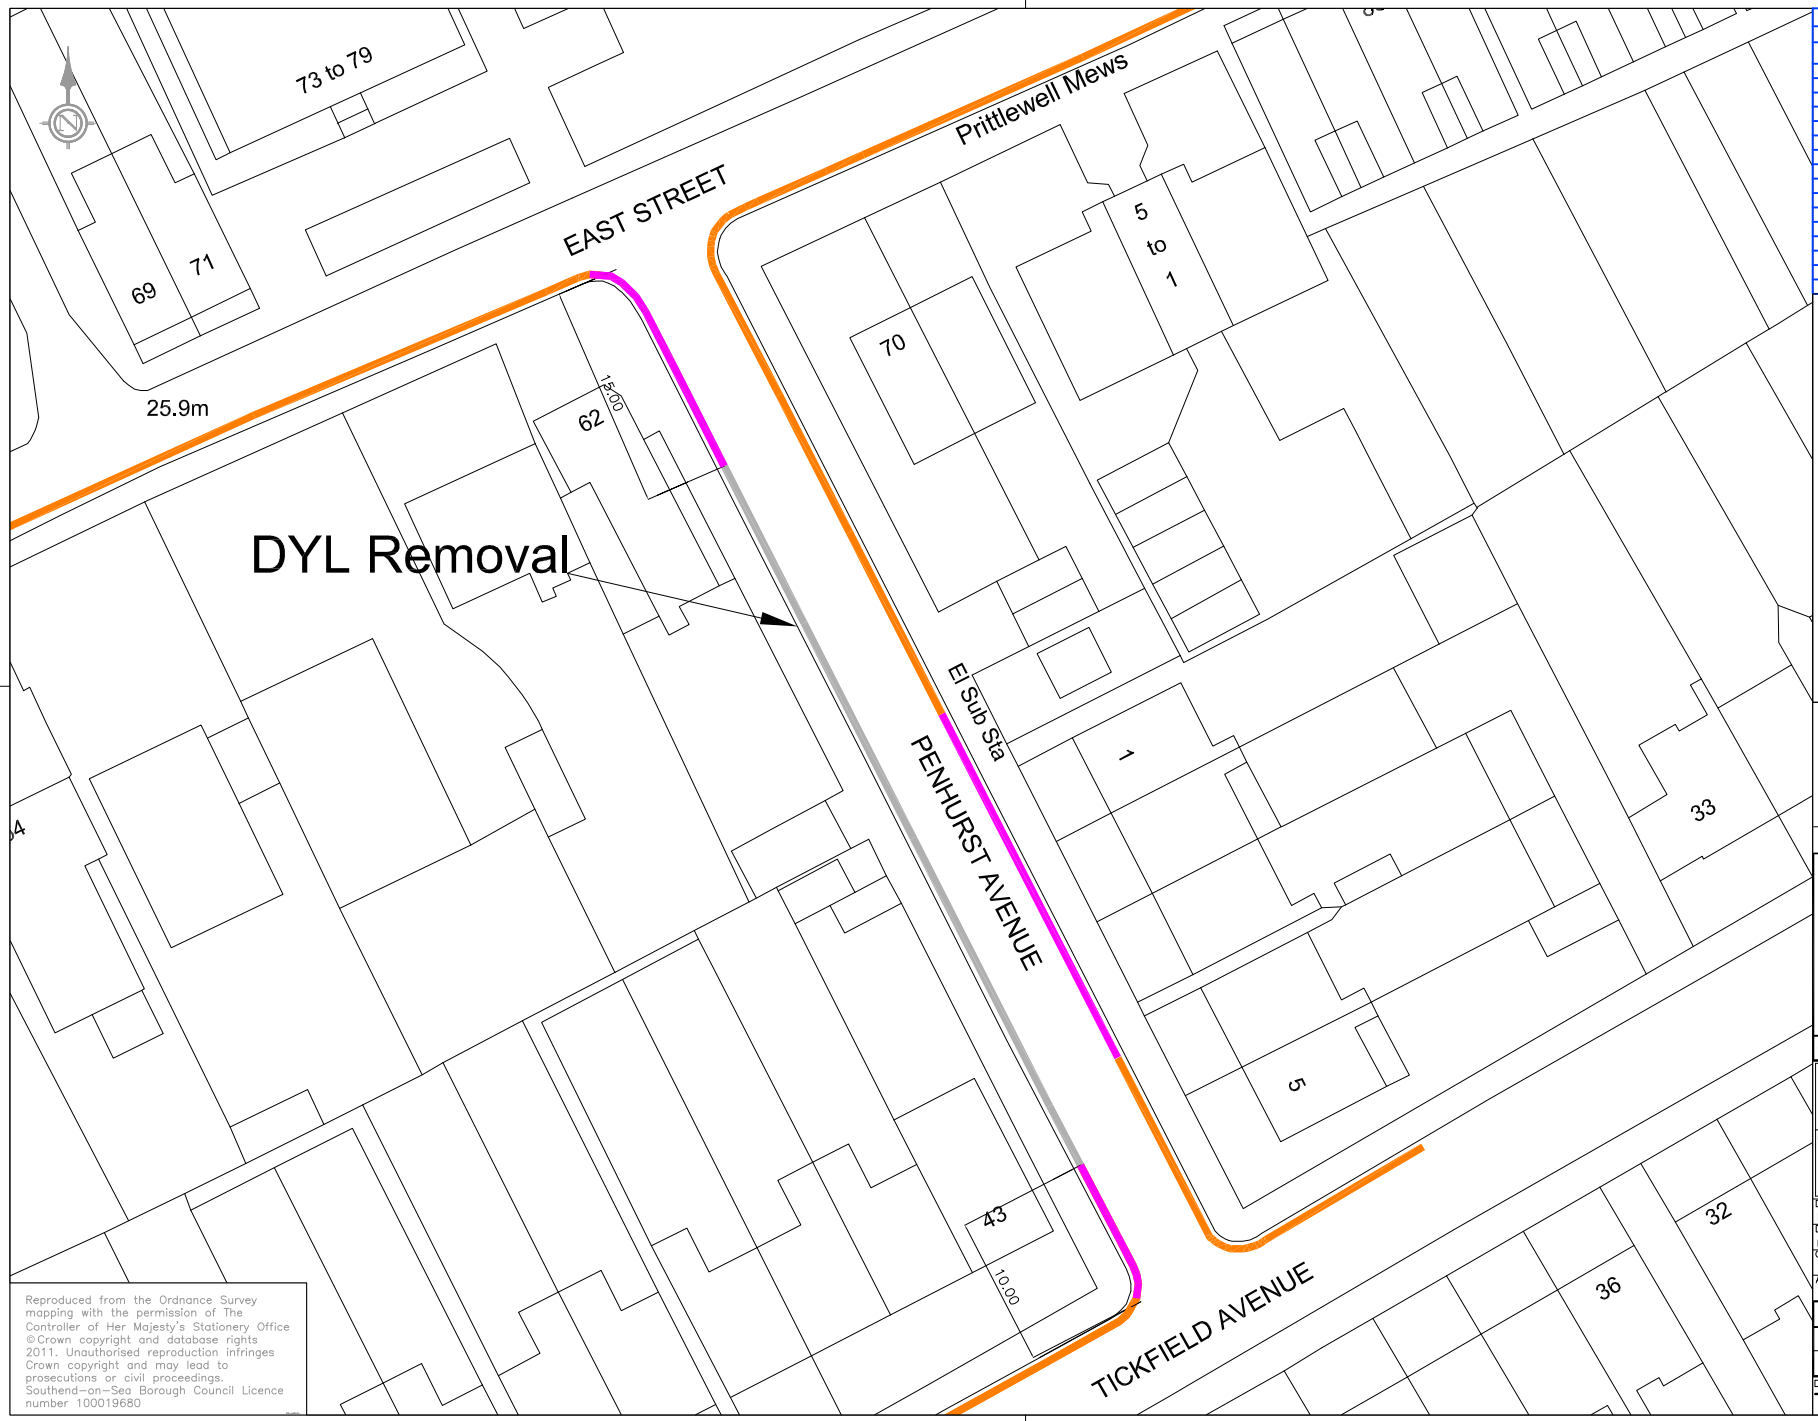

Reproduced from the Ordnance Survey mapping with the permission of The Controller of Her Majesty's Stationery Office ©Crown copyright and database rights 2011. Unauthorised reproduction infringes Crown copyright and may lead to prosecutions or civil proceedings. Southend-on-Sea Borough Council Licence number 100019680

Revisions

Rev	Details	Date
1	TH/P/3074_02_ DYL Request 24 Aug 2011 V1	24/08/2011
2	TH/P/3074_02_ DYL Request 24 Aug 2011 V2	24/08/2011
3	TH/P/3074_02_ DYL Request 24 Aug 2011 V3	24/08/2011
4	TH/P/3074_02_ DYL Request 24 Aug 2011 V3	25/08/2011
5	TH/P/3074_02_ DYL Request 24 Aug 2011 V3	30/08/2011

Key
- Current Double Yellow Lines
- Current Single Yellow Lines
- Proposed Double Yellow Lines
- Proposed Single Yellow Lines
- Proposed Removal Double Yellow L

No.	Copies sent to	Date

Southend-on-Sea Borough Council

Enterprise, Tourism and the Environment

PO Box 5560, Civic Centre
Victoria Avenue, Southend on Sea,
SS2 6ZQ

Quality Project No. : 3074

Project Title
Junction Protection and DYL Requests

Drawing Title
Penhurst Avenue
Plan 1

Designed by LT
Drawn LT Date 30/08/11
Checked Date / /
Approved Date / /
Scales @ A3 Not To Scale
Issued Date

Drawing Status

Preliminary		Working	
Tender		As Constructed	

Drawing Number
TH/P/3074_02_ DYL V3

SBC A3 Titlebox edited by PWM Rev: A3-052011